


Map No. **KANSAS** Sec. 19 Twp. 28 R. 1E
Well No. 1 Jeffries Farm
Shawver & Polhamus Company

Sedgwick

NORTH

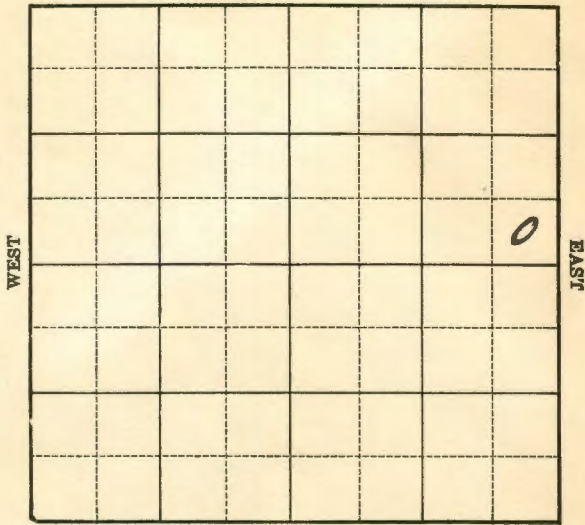

SOUTH

Location NE SE SE
Drilling Remarks

Rig Up
Drilling Remarks

RECORD
Cased _____ in. _____ ft.
Sand _____
Gas _____
Oil _____
Total Depth _____

PRODUCTION
1st 24 hrs. Nat. _____
1st 24 hrs. after shot _____
Gas _____ cu. ft. _____
Dry Hole _____
Abandoned _____

Map No. **KANSAS** Sec. 19 Twp. 28 R. 1E
Well No. 1 Jeffries Farm
Shawver & Polhamus Company

Sedgwick


NORTH

_____ Ft. from N. Line

330 Ft. from S. Line

330 Ft. from E. Line

_____ Ft. from W. Line

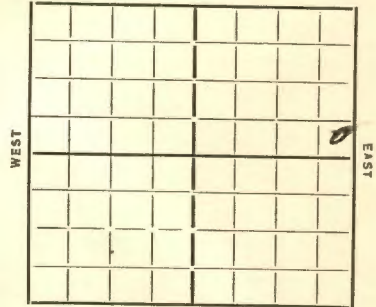

SOUTH

Date 1935

REPORT

1/7 10" 93
1/10 _____
1/17 Top Chat 3112 1/2
1/24 3151 log drill pipe
1/30 Chat 3125 TD 3151 D & A

ABANDONED

KANSAS

Map No. 12 Sec. 19 Twp. 28 R. 1E

Well No. 1-9 gaffins

Shawver + Jollamus Company

Contractor

FIRST REPORTS

SECTION PLAT

Ft. from N. Line
330 Ft. from S. Line
330 Ft. from E. Line
Ft. from W. Line

			0

Location.....
Rig up.....
Drilling and Remarks:

10" 93

RECORD

Cased..... in., ft.
Sand.....
Gas.....
Oil.....
Total Depth.....

PRODUCTION

1st 24 hrs. Nat.....
1st 24 hrs. after shot.....
Gas..... Cu. Ft.
Dry Hole.....
Abandoned.....

Date 1-2-35 192

ORVAL MANNSCHECK Scout

KANSAS

Map No. 12 Sec. 19 Twp. 28 R. 1E

Well No. 1-9 gaffins

Shawver + Jollamus Company

Contractor

ABANDONED

SECTION PLAT

Ft. from N. Line
330 Ft. from S. Line
330 Ft. from E. Line
Ft. from W. Line

			0

Location.....
Rig up.....
Drilling and Remarks:

W + H

RECORD

Cased..... in., ft.
Sand Chat 312.5
Gas.....
Oil.....
Total Depth 3151

PRODUCTION

1st 24 hrs. Nat.....
1st 24 hrs. after shot.....
Gas..... Cu. Ft.
Dry Hole.....
Abandoned.....

Date 1-30-35 192

ORVAL MANNSCHECK Scout