


DX 78-1

SEDGWICK

KANSAS

Section 19 Township 28S Range 1E
 Well No. #3 Long
 Company Adair Oil Co.

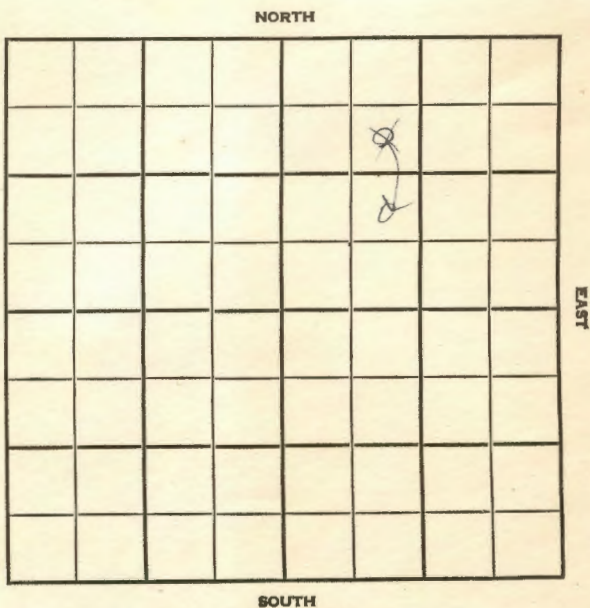

Sedgwick

KANSAS

SEC. 19 TWP. 28 R. 1E
 WELL NO. #3 Long
 COMPANY Adair Oil Co. FARM

CONTRACTOR Adair

Gladys

990 FT. FROM N. LINE


FT. FROM S. LINE

FT. FROM E. LINE

830 FT. FROM W. LINE

SE NW NE of NE 1/4

NE SW NE

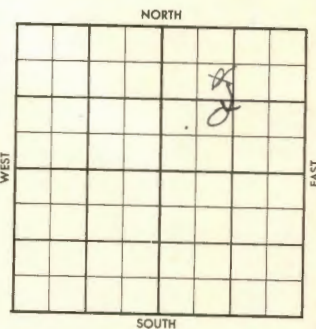

1956

ELEVATION

1274

REPORT

6-13

MIRT

6-27

Comm. 6-12-56
 8 5/8" @ 160/100
 Drlg. 2756
 H. Stall 2304; K.C. 2618; BKC. 2803;
 M. chert 3112; M. Dolo 3118
 TD. 3221

D & A

ABANDONED

CORRECTION

FORM 513 SUNRAY

County Sedwick Elev. 1274
Sec. 19 Twp. 28S Rge. 1E
Company Adair Oil Co.
FarmName Long No. 3

TOPS	DEPTH	LOG	DATUM	Loc. in Sec.
				<u>NE NW NE</u>
				<u>SW NW NE</u>
TP	<u>Stall</u>	<u>2304</u>		<u>830' fnl x</u>
Tr.				<u>830' fnl x</u>
Dg.				
Bl.				
L.				
K.C.	<u>2618</u>			
B.K.C.	<u>2823</u>			
Ce.				
M.	<u>chert</u>	<u>3113</u>		
M.	<u>Dolo</u>	<u>3118</u>		
K.				
Mz.				
V.				
S.				
A.				
R.				
PC.				
G.				
TD	<u>3221</u>			

ABANDONED

Date Comm. MTBT JUN 20 '56 6-12-56 JUN 27 '56
85/8 160/100 IP 2756 JUN 27 '56

D&A

FORM 513 SUNRAY

County Sedwick Elev. 1274
Sec. 19 Twp. 28S Rge. 1E
Company Adair Oil Co.
FarmName Long No. 3

TOPS	DEPTH	LOG	DATUM	Loc. in Sec.
				<u>SE NW NE</u>
TP				<u>990' fnl x</u>
Tr.				<u>830' fnl x</u>
Dg.				
Bl.				
L.				
K.C.				
B.K.C.				
Ce.				
M.				
M.				
K.				
Mz.				
Me.				
V.				
S.				
S.				
A.				
R.				
PC.				
G.				
TD				

FIRST REPORT

JUN 13 '56

Date Comm. MIRT

JUN 5 1956

D.A.