Sedgwick


KANSAS

SECTION 19 TOWNSHIP 28 RANGE 1E

WELL NO. #1 Schnitzler

COMPANY Ed Adair

NORTH

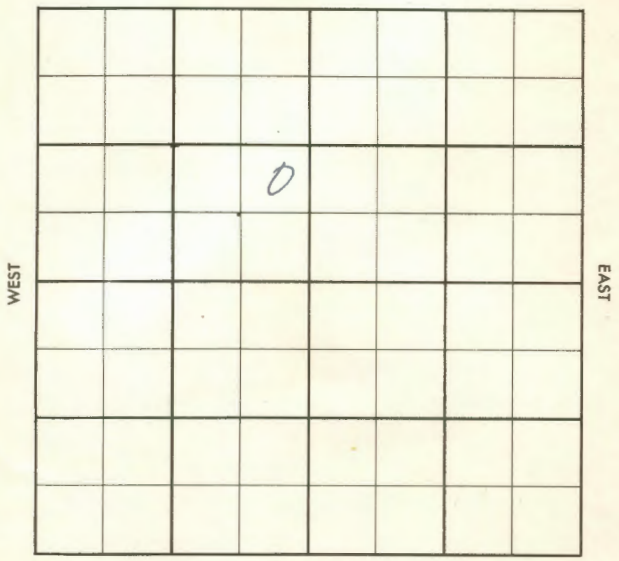

FORM 504-3 SUNRAY

Sedgwick KANSAS

SEC.	TWP.	R.
19	28	1E

WELL NO. #1 Schnitzler FARM

COMPANY Ed Adair

CONTRACTOR Co. Tools

Gladys

_____ Ft. from N. Line

_____ Ft. from S. Line


_____ Ft. from E. Line

_____ Ft. from W. Line

NE SE NW

####

NORTH

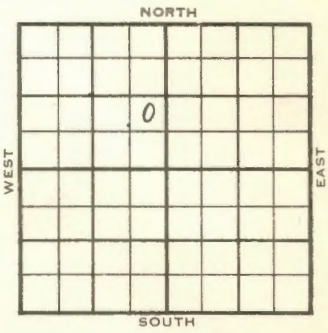

1956	ELEVATION 1276	REPORT
4-4	Loc.	
4-18	Comm. 4-13-56 8 5/8" @ 151 w/135 DST 2736-51 op 45 min. rec. 5' mud, 0/20" D & A H. 2052 Stal 2291 L. 2279 KC 2627 M. Chert 3127 M. Dolo 3138 TD 3143'	

ABANDONED

DX-78

FORM 513 REV. SUNRAY

County Sedgwick Elev. 1276

Sec. 19 Twp. 28 Rge. 1E

Company Ed Adair

Farm Name Schnitzler No. 1

TOPS	DEPTH	LOG	DATUM
Anh.			
Tp.			
H.	2052		
Tr.			
Dg. Stal	2291		1015
Bl.			
L.	3279		1003
K.C.	2627		1357
B.K.C.			
Ce.			
C.			
M. Chest	3127		1851
M. Lolo	3138		1862
K.			
Mz.			
Mo.			
V.			
S.			
S.			
A			
R.			
P€.			
G.			
TD	3143		

Loc. in Sec. NE SE NW

Geol.

Contr. Co. tools

Pool Gladys

ABANDONED

APR 1 8 1956

Date Comm. 4-13-56

8 5/8" @ 151/135 DST 2736-51

open 45 min. rec. 5' mud 0/20"

D & A

Co. Lse. No. Sec. T. R.

FORM 513 SUNRAY

County Sedgwick Elev.

Sec. 19 Twp. 28 Rge. 1E

Company Ed Adair

Farm Name Schnitzler No. 1

TOPS	DEPTH	LOG	DATUM
Anh.			
Tp.			
H.			
Tr.			
Dg.			
Bl.			
L.			
K.C.			
B.K.C.			
Ce.			
C.			
M.			
M.			
K.			
Mz.			
Mo.			
V.			
S.			
S.			
A			
R.			
P€.			
G.			
TD			

Loc. in Sec. NE SE NW

Geol.

Contr. Co. tools

Pool Gladys

APR 4 '56

FIRST REPORT

Date Comm. Location

APR 10 1956

R.C.

Co. Lse. No. Sec. T. R.