


Map No. KANSAS Sec. 70 Twp. 28 R. 1E

Well No. #2 Brown Rickey Oil Farm \_\_\_\_\_ Company \_\_\_\_\_

NORTH

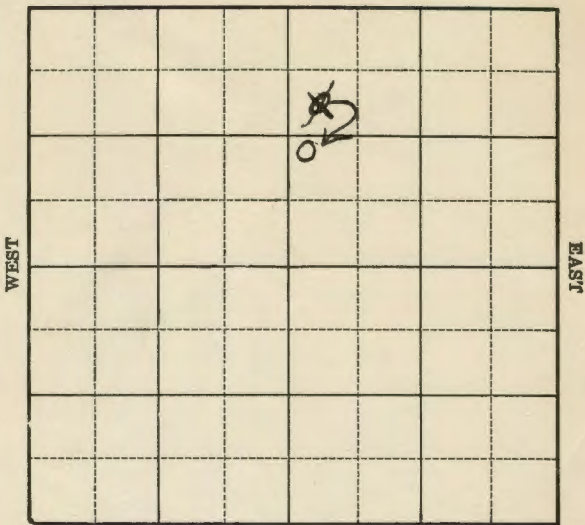

SOUTH

Location \_\_\_\_\_  
Drilling Remarks \_\_\_\_\_

Rig Up \_\_\_\_\_  
Drilling Remarks \_\_\_\_\_

**RECORD**

Cased \_\_\_\_\_ in. \_\_\_\_\_ ft.  
 Sand \_\_\_\_\_  
 Gas \_\_\_\_\_  
 Oil \_\_\_\_\_  
 Total Depth \_\_\_\_\_

**PRODUCTION**


1st 24 hrs. Nat. \_\_\_\_\_  
 1st 24 hrs. after shot \_\_\_\_\_  
 Gas \_\_\_\_\_ cu. ft. \_\_\_\_\_  
 Dry Hole \_\_\_\_\_  
 Abandoned \_\_\_\_\_

Map No. KANSAS Sec. 70 Twp. 28 R. 1E

Well No. 2 Brown Rickey Oil Farm \_\_\_\_\_ Company \_\_\_\_\_

NORTH

~~990~~ Ft. from N. Line  
 990 Ft. from S. Line  
 \_\_\_\_\_ Ft. from E. Line  
 330 Ft. from W. Line

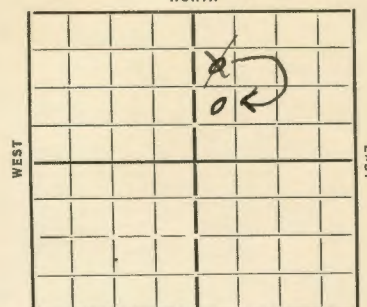

SOUTH

REPORT

Date 1935  
 1/9 Location  
 1/17 Dlg 2175  
 1/24 3097 Coring  
 1/31 6" 3096 Gas 3121 Chit 3128  
 Oil 3134 Dlg 3150 H.F.O.  
 2/6 Chit 3128 T-1 3162  
 830 Bbl Show Water.

COMPLETED.

KANSAS

Map No. 17 Sec. 20 Twp. 28 R. 1E

Well No. 2-Brown  
Dickey oil Company

Contractor

COMPLETED

SECTION PLAT

		0	

Ft. from N. Line

990 Ft. from S. Line

Ft. from E. Line

330 Ft. from W. Line

Location

Rig up

Drilling and Remarks:

830 lbs

Show water

RECORD

Cased \_\_\_\_\_ in., \_\_\_\_\_ ft.  
 Sand Chat 3128  
 Gas \_\_\_\_\_  
 Oil \_\_\_\_\_  
 Total Depth 3162

PRODUCTION

1st 24 hrs. Nat. \_\_\_\_\_  
 1st 24 hrs. after shot \_\_\_\_\_  
 Gas \_\_\_\_\_ Cu. Ft.  
 Dry Hole \_\_\_\_\_  
 Abandoned \_\_\_\_\_

Date

2-6-35 192

ORVAL MANNSCHRECK

Scout

ORVAL MANNSCHRECK

KANSAS

Map No. 17 Sec. 20 Twp. 28 R. 1E

Well No. 2-Brown  
Dickey oil Company

Contractor

FIRST REPORTS

SECTION PLAT

990 Ft. from N. Line

Ft. from S. Line

Ft. from E. Line

330 Ft. from W. Line

		0	

Location ✓

Rig up

Drilling and Remarks:

RECORD

Cased \_\_\_\_\_ in., \_\_\_\_\_ ft.  
 Sand \_\_\_\_\_  
 Gas \_\_\_\_\_  
 Oil \_\_\_\_\_  
 Total Depth \_\_\_\_\_

PRODUCTION

1st 24 hrs. Nat. \_\_\_\_\_  
 1st 24 hrs. after shot \_\_\_\_\_  
 Gas \_\_\_\_\_ Cu. Ft.  
 Dry Hole \_\_\_\_\_  
 Abandoned \_\_\_\_\_

Date

1-9-35 192

ORVAL MANNSCHRECK

Scout

Map No. 17 Sec. 20 Twp. 28 R. 1E

Well No. 2-Brown

Dickie oil Company

Contractor

**CORRECTION**

**SECTION PLAT**

Ft. from N. Line

990 Ft. from S. Line

Ft. from E. Line

330 Ft. from W. Line

		0	

**CORRECTION**

**RECORD**

Location..... Cased..... in., .....ft.

Rig up..... Sand.....

Drilling and Remarks: Gas.....

Oil.....

Total Depth.....

**PRODUCTION**

1st 24 hrs. Nat.....

1st 24 hrs. after shot.....

Gas..... Cu. Ft.

Dry Hole.....

Abandoned.....

*formerly reported as SW NW 7 E*

Date

1-16-35 192... **OPAL MANNSCHECK** Scout