

Map No. **KANSAS** Sec. 20 Twp. 28 R. 1E


Well No. 2-Cook Farm Johnson & Atlantic Company

*Sedgwick*

NORTH

WEST

EAST

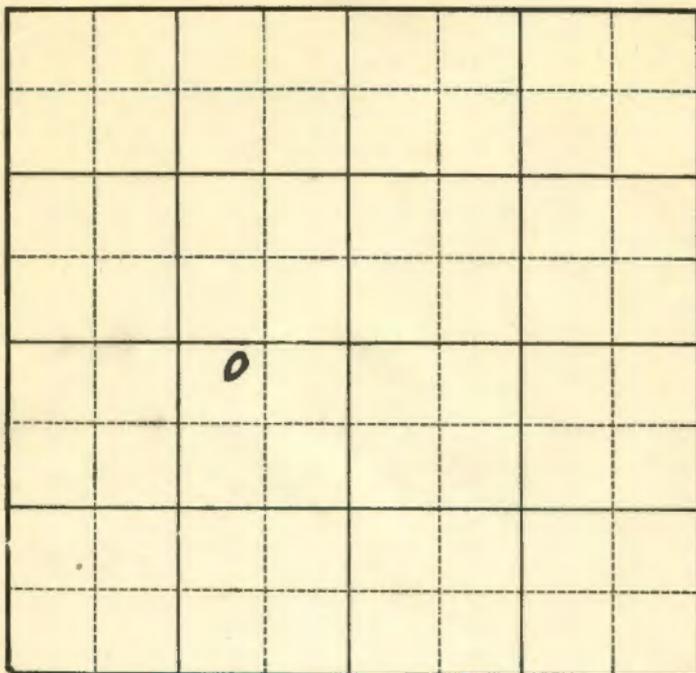

SOUTH

Location \_\_\_\_\_

Drilling Remarks \_\_\_\_\_

\_\_\_\_\_

\_\_\_\_\_

Rig Up \_\_\_\_\_

Drilling Remarks \_\_\_\_\_

\_\_\_\_\_

\_\_\_\_\_

RECORD

Cased \_\_\_\_\_ in. \_\_\_\_\_ ft.

Sand \_\_\_\_\_

Gas \_\_\_\_\_

Oil \_\_\_\_\_

Total Depth \_\_\_\_\_

PRODUCTION

1st 24 hrs. Nat. \_\_\_\_\_

1st 24 hrs. after shot \_\_\_\_\_

Gas \_\_\_\_\_ cu. ft.

Dry Hole \_\_\_\_\_

Abandoned \_\_\_\_\_

Hedgwick

Map No. **KANSAS** Sec. 20 Twp. 28 R. 1E

Well No. 2-Cook Farm

Johnson & Atlantic Company


NORTH

330 Ft. from N. Line

Ft. from S. Line

884 Ft. from E. Line

Ft. from W. Line

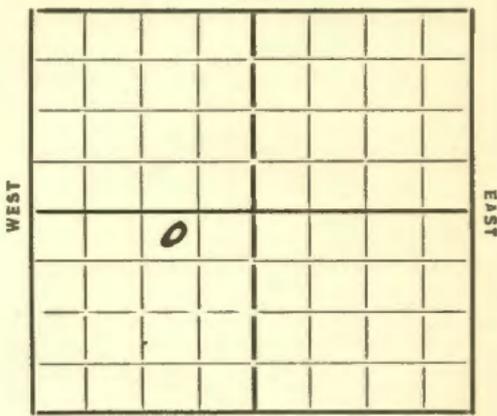

NW NE SW

REPORT

293.5  
 4/10 10" 86 WOC  
 4/18 dly 1740  
 4/26 TC 3095 6" 3093 T7 3096  
 Rest  
 5/2 T7 3114 2000' oil  
 trace w. PBI foot  
 5/8 TL 3095 T7 3114  
 1000 acid 819 Bbls oil

**COMPLETED**

Map No. *12* Sec. *20* Twp. *28* R. *1 E*

Well No. *2-Cook*

*Johnson + Atlantic* Company

Contractor

FIRST REPORTS

SECTION PLAT

*330* Ft. from N. Line  
Ft. from S. Line  
*884* Ft. from E. Line  
Ft. from W. Line

	o		

Location.....

Rig up.....

Drilling and Remarks:

*10" 86'*  
*WOC*

RECORD

Cased.....in., .....ft.  
Sand.....  
Gas.....  
Oil.....  
Total Depth.....

PRODUCTION

1st 24 hrs. Nat.....  
1st 24 hrs. after shot.....  
Gas.....Cu. Ft.  
Dry Hole.....  
Abandoned.....

Date  
*4-10-35* 192.....

ORVAL MANNSCHRECK

Scout

MMS

*Bedgwick*  
 Map No. 12 Sec. 20 Twp. 28 R. 1 E  
 Well No. 2-cook  
Johnson & Atlantic Company  
 Contractor

**COMPLETED**

**SECTION PLAT**

330 Ft. from N. Line  
 \_\_\_\_\_ Ft. from S. Line  
884 Ft. from E. Line  
 \_\_\_\_\_ Ft. from W. Line

	0		

Location \_\_\_\_\_  
 Rig up \_\_\_\_\_  
 Drilling and Remarks:

*1000 sand*  
  
*819 oil*

**RECORD**

Cased \_\_\_\_\_ in., \_\_\_\_\_ ft.  
 Sand JK 3095  
 Gas \_\_\_\_\_  
 Oil \_\_\_\_\_  
 Total Depth 3114

**PRODUCTION**

1st 24 hrs. Nat. \_\_\_\_\_  
 1st 24 hrs. after shot \_\_\_\_\_  
 Gas \_\_\_\_\_ Cu. Ft.  
 Dry Hole \_\_\_\_\_  
 Abandoned \_\_\_\_\_

Date 5-8-35 192