


Sedgwick

Map No. KANSAS Sec. 20 Twp. 28 R. 1E

Well No. 1 *Heath* Farm
Rickey Oil Company

990 Ft. from N. Line
 Ft. from S. Line
330 Ft. from E. Line
 Ft. from W. Line

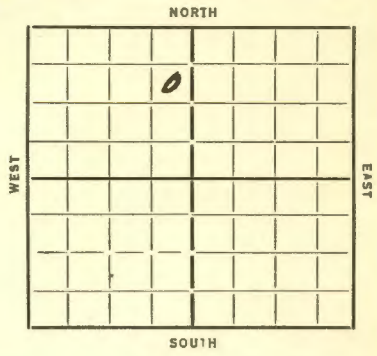

REPORT

935
1/2 *Blky. Rot. Rig*
1/10 *Rig*
1/17 *Dly 2095*
1/24 *Chat 3115 3118 6° 3116*
1/31 *Rust*
2/7 *Chat. Corrected 3118*
Oil 3126 Inc 3130-37 T 7 3152
Testing
2/13 *Chat 3118 T 7 3154*
1000 acid P. 694 Bbls.

COMPLETED

Map No. 12 Sec. 20 Twp. 28 R. 15

Well No. 1-Heath

Wickey Oil Company

FIRST REPORTS Contractor

SECTION PLAT

990 Ft. from N. Line

..... Ft. from S. Line

330 Ft. from E. Line

..... Ft. from W. Line

	0		

Location.....

Rig up.....

Drilling and Remarks:

Blow, Rot. Rig

RECORD

Cased.....in.,ft.

Sand.....

Gas.....

Oil.....

Total Depth.....

PRODUCTION

1st 24 hrs. Nat.....

1st 24 hrs. after shot.....

Gas.....Cu. Ft.

Dry Hole.....

Abandoned.....

Date

1-2-35 192.....

ORVAL MANNSCHRECK

Scout

Map No. 12 Sec. 20 Twp. 28 R. 1E

Well No. 1-Heath

Dirty Oil

Company

Contractor

COMPLETED

SECTION PLAT

990 Ft. from N. Line

..... Ft. from S. Line

330 Ft. from E. Line

..... Ft. from W. Line

Location.....

Rig up.....

Drilling and Remarks:

road acid

P. 694 bbb

RECORD

Cased..... in, ft.

Sand Chat 3118

Gas.....

Oil.....

Total Depth 3154

PRODUCTION

1st 24 hrs. Nat.....

1st 24 hrs. after shot.....

Gas..... Cu. Ft.

Dry Hole.....

Abandoned.....

Date

ORVAL MANNSCHECK

2-13-35 192.....

Scout