
Form 51—5M—3-35—Mid-West

Map No. KANSAS Sec. 20 Twp. 28 R. 16

Well No. 7 - Heath Farm

Dickey Company

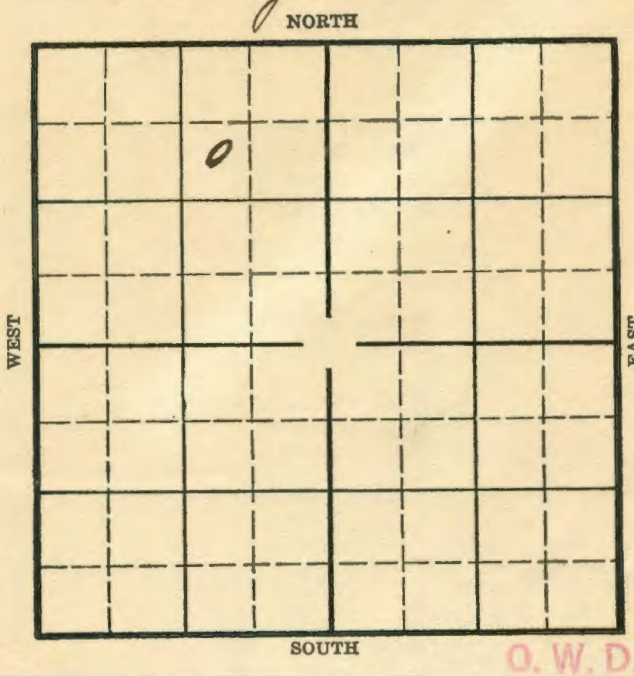

O.W.D.D

Location

Drilling Remarks

Rig Up

Drilling Remarks

RECORD

Cased ____ in. ____ ft.

Sand

Gas

Oil

Total Depth

PRODUCTION

1st 24 hrs. Nat.

1st 24 hrs. after shot

Gas ____ cu. ft.

Dry Hole

Abandoned

Form 252-A
5M 7-35 MPC

Hedgcock

Map No. KANSAS Sec. 20 Twp. 28 R. 1E

Well No. 2- Heath

Dickey Farm


Company

990 Ft. from N. Line

Ft. from S. Line

990 Ft. from E. Line

Ft. from W. Line

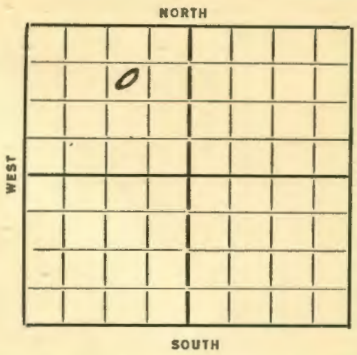

Elev. 1275

Date	REPORT
7/25	Dlg 1300
10/3	" 2625
10/10	TC 3085 6" 3085
	TD 3090 Boiling
11/4	TD 3150 SD.
11/7	— 11/14 — 11/21 — 11/29 — 12/6 —
12/13	— 12/19 — 12/26 — 1/2/36 —
1/8	Chat 3085
	TD 3150
	D & A.
	ABANDONED
1937	O. W. D. D
2/8	Old T.D. 3150'.
	8" @ 3085'.
	Chat 3085'.
	5" @ 3490'. WOC.

OVER

535466

1937

12/17 Wilcox 3494'. T.D. 3540'.
S. W. SDO.

12/22 Old T.D. 3150'.
Wilcox 3494'.
T.D. 3547'.
3000' fluid.

ABANDONED

Form 26—1M Bks.—2-29

Sedgwick KANSAS

Map No. 12 Sec. 20 Twp. 28 R. 1E

Well No. 2 Heath

Dickey Company

Contractor

FIRST REPORT

SW NE NW


990 Ft. from N. Line

Ft. from S. Line

990 Ft. from E. Line

Ft. from W. Line

SECTION PLAT

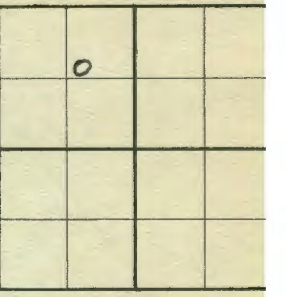

Location

Rig up

Drilling and Remarks:

OWDD. OTD 3150
6" 3084
Chat 3085
5" 3490 - WOC

RECORD

Cased in., ft.

Sand

Gas

Oil

Total Depth

PRODUCTION

1st 24 hrs. Nat.

1st 24 hrs. after shot

Gas Cu. Ft.

Dry Hole

Abandoned

Date

DEC 8 - 1937 19 H. D. Hatfield Scout

Form 26—1M Bks.—2-29

Sedgwick KANSAS

Map No. 12 Sec. 20 Twp. 28 R. 1E

Well No. 2 Heath

Dickey Company

Contractor

ABANDONED

SW NE NW


990 Ft. from N. Line

Ft. from S. Line

990 Ft. from E. Line

Ft. from W. Line

SECTION PLAT

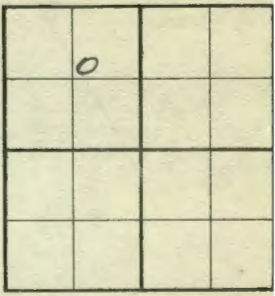

Location

Rig up

Drilling and Remarks:

OWDD OTD 3150

3000' Fluid

D & A

RECORD

Cased in., ft.

Sand Wilcox 3494

Gas

Oil

Total Depth 3547

PRODUCTION

1st 24 hrs. Nat.

1st 24 hrs. after shot

Gas Cu. Ft.

Dry Hole

Abandoned

Date

DEC 2 2 1937 19

H. D. Hatfield Scout