


Map No. **KANSAS** Sec. **20** Twp. **28** R. **1E**

Well No. **2 - Heath** Farm \_\_\_\_\_

**Dickey** Company \_\_\_\_\_

NORTH

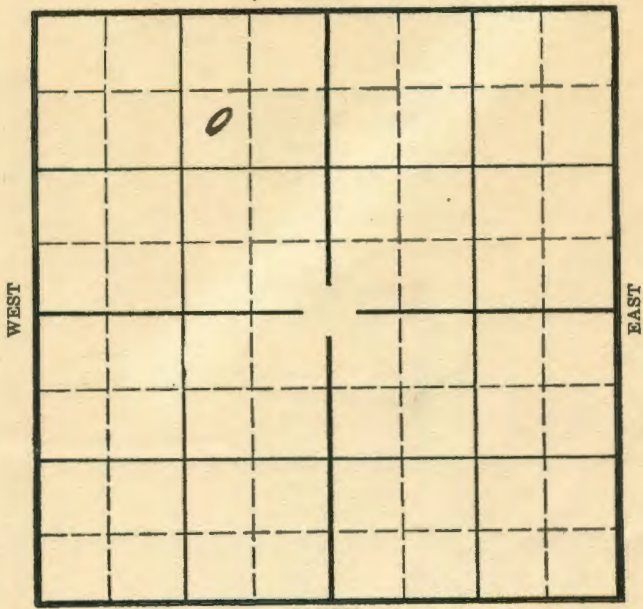

SOUTH

O. W. D. D

Location \_\_\_\_\_

Drilling Remarks \_\_\_\_\_

Rig Up \_\_\_\_\_

Drilling Remarks \_\_\_\_\_

RECORD

Cased \_\_\_\_\_ in. \_\_\_\_\_ ft.

Sand \_\_\_\_\_

Gas \_\_\_\_\_

Oil \_\_\_\_\_

Total Depth \_\_\_\_\_

PRODUCTION

1st 24 hrs. Nat. \_\_\_\_\_

1st 24 hrs. after shot \_\_\_\_\_

Gas \_\_\_\_\_ cu. ft. \_\_\_\_\_

Dry Hole \_\_\_\_\_


Abandoned \_\_\_\_\_

*Hedgwick*  
28 R. 1E

Map No. **KANSAS** Sec. **20** Twp. **28** R. **1E**

Well No. **2-Heath** Farm \_\_\_\_\_  
**Dickey** Company \_\_\_\_\_

**990** Ft. from N. Line  
\_\_\_\_\_ Ft. from S. Line  
**990** Ft. from E. Line  
\_\_\_\_\_ Ft. from W. Line

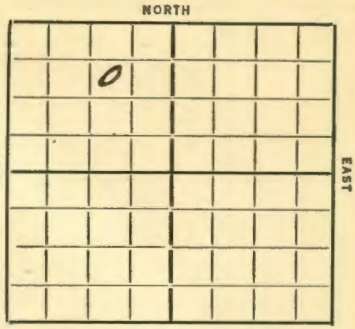

**Elev. 1275**

Date \_\_\_\_\_ REPORT **O. W. D. D.**

*9/25*  
*2/25* *Wlg 1300*  
*10/3* *" 2625*  
*10/10* *TC 3085 6" 3085*  
*TD 3090 Bailing*  
*11/4* *TD 3150 SD.*  
*11/7* *— 11/14 — 11/21 — 11/29 — 12/6 —*  
*2/13* *— 12/19 — 12/26 — 1/2/36 —*  
*1/8* *Chat 3085*  
*TD 3150*  
*D. A.*

**ABANDONED**

**937** **O. W. D. D.**

*2/8* **Old T.D. 3150'.**  
**8" @ 3085'.**  
**Chat 3085'.**  
**5" @ 3490'.** **WOC.**

**OVER**

Map No. 12 Sec. 20 Twp. 28 R. 1E

Well No. 2-Heath

Sickey Oil Company

Contractor

SECTION PLAT

990 Ft. from N. Line

Ft. from S. Line

990 Ft. from E. Line

Ft. from W. Line

	0		

COMPLETED

Location

Rig up

Drilling and Remarks:

H.V. a.

RECORD

Cased in., ft.

Sand Chat 3085

Gas

Oil

Total Depth 2150

PRODUCTION

1st 24 hrs. Nat.

1st 24 hrs. after shot

Gas Cu. Ft.

Dry Hole

Abandoned

Date

JAN 8 1936 192

ORVAL MANNSCHRECK Scout

Map No. 12 Sec. 20 Twp. 28 R. 1E

Well No. 2-Heath

Hickey

Company

Contractor

FIRST REPORTS

SECTION PLAT

990 Ft. from N. Line

Ft. from S. Line

990 Ft. from E. Line

Ft. from W. Line

	o		

Location

Rig up

Drilling and Remarks:

2 1/2 1300

RECORD

Cased \_\_\_\_\_ in., \_\_\_\_\_ ft.

Sand \_\_\_\_\_

Gas \_\_\_\_\_

Oil \_\_\_\_\_

Total Depth \_\_\_\_\_

PRODUCTION

1st 24 hrs. Nat. \_\_\_\_\_

1st 24 hrs. after shot \_\_\_\_\_

Gas \_\_\_\_\_ Cu. Ft.

Dry Hole \_\_\_\_\_

Abandoned \_\_\_\_\_

Date

9-25-35

ORVAL MANNSCHRECK

Scout