


STATE OF KANSAS  
STATE CORPORATION COMMISSION

Give All Information Completely  
Make Required Affidavit  
Mail or Deliver Report to:  
Conservation Division  
State Corporation Commission  
211 No. Broadway  
Wichita, Kansas

WELL PLUGGING RECORD

NORTH

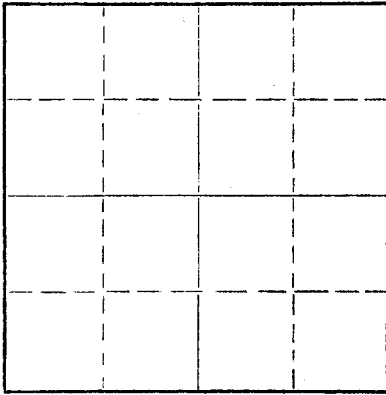

Locate well correctly on above  
Section Plat

Location as "NE/CNW&SW&SE" or footage from lines Neosho County. Sec. 11 Twp. 28S Rge. 17E (E) (W)  
Location as "NE/CNW&SW&SE" or footage from lines SW SE SE  
Lease Owner Kenneth C. Keas  
Lease Name Arthur Well No. 1  
Office Address Box 556, Chanute, Kansas 66720  
Character of Well (completed as Oil, Gas or Dry Hole) dry  
Date well completed 3-27-65 19  
Application for plugging filed 4-8-66 19  
Application for plugging approved " 19  
Plugging commenced " 19  
Plugging completed " 19  
Reason for abandonment of well or producing formation \_\_\_\_\_

If a producing well is abandoned, date of last production \_\_\_\_\_ 19  
Was permission obtained from the Conservation Division or its agents before plugging was commenced? Yes

Name of Conservation Agent who supervised plugging of this well Vic Simoncic  
Producing formation \_\_\_\_\_ Depth to top \_\_\_\_\_ Bottom \_\_\_\_\_ Total Depth of Well 1075 Feet  
Show depth and thickness of all water, oil and gas formations.

OIL, GAS OR WATER RECORDS

CASING RECORD

FORMATION	CONTENT	FROM	TO	SIZE	PUT IN	PULLED OUT
Well log on back						

Describe in detail the manner in which the well was plugged, indicating where the mud fluid was placed and the method or methods used in introducing it into the hole. If cement or other plugs were used, state the character of same and depth placed, from \_\_\_\_\_ feet to \_\_\_\_\_ feet for each plug set.

Run in eight sacks cement at bottom. Set bridge at 150' and put in five sacks cement. Set bridge at 25' and put in five sacks cement. Dirt to top.

(If additional description is necessary, use BACK of this sheet)

Name of Plugging Contractor K-K Drilling Company  
Address Box 556, Chanute, Kansas License No. 573

STATE OF KANSAS, COUNTY OF NEOSHO, ss.  
Kenneth C. Keas (~~owner~~) (~~owner~~) of the above-described well, being first duly sworn on oath, says: That I have knowledge of the facts, statements, and matters herein contained and the log of the above-described well as filed and that the same are true and correct. So help me God.

(Signature) \_\_\_\_\_  
Box 556, Chanute, Kansas  
(Address)

SUBSCRIBED AND SWORN TO before me this 16th day of April, 19 66

My commission expires 10-22-67 Janet Bloomer Notary Public.



10	dirt	10
131	shale	141
15	lime	156
10	shale	166
291	lime	457
89	shale	546
37	lime	583
31	shale	614
36	lime	650
77	shale	727
53	lime	780
34	shale	814
45	lime	859
68	shale	927
14	sand	941
6	shale	947
4	sand	951
10	shale	961
15	sand	976
13	shale	989
14	sand	1003
28	shale	1031
44	lime	1075