

STATE CORPORATION COMMISSION OF KANSAS  
OIL & GAS CONSERVATION DIVISION

WELL COMPLETION OR RECOMPLETION FORM  
ACO-1 WELL HISTORY

DESCRIPTION OF WELL AND LEASE

Operator: license # 6001  
name Robert E. Austin  
address P.O. Box 1406  
City/State/Zip Miami, Oklahoma 74355

Operator Contact Person Max Alcock  
Phone 316-431-4267

Contractor: license # 5667  
name Howard Louerty

Site Geologist  
Phone

Designate Type of Completion

New Well  Re-Entry  Workover

Oil  SWD  Temp Abd  
 Gas  Inj  Delayed Comp.  
 Dry  Other (Core, Water Supply etc.)

If OWWO: old well info as follows:

Operator  
Well Name  
Comp. Date Old Total Depth

WELL HISTORY

Drilling Method:  Mud Rotary  Air Rotary  Cable

8/28/85 8/30/85 8/30/85  
Start Date Date Reached TD Completion Date

671   
Total Depth PBD

Amount of Surface Pipe Set and Cemented at 20 feet

Multiple Stage Cementing Collar Used?  Yes  No

If Yes, Show Depth Set \_\_\_\_\_ feet

If alternate 2 completion, cement circulated  
from \_\_\_\_\_ feet depth to \_\_\_\_\_ w/ \_\_\_\_\_ SX cmt

API NO. 15- 037-21,363 **26-28-21E**

County Crawford

N.W. NE. SW. NW. Sec. 26 Twp. 28 Rge. 21  
(Location)

3795 Ft North from Southeast Corner of S  
4455 Ft West from Southeast Corner of S  
(Note: locate well in section plat below)


Lease Name Fax B Well# 4B

Field Name Unnamed

Producing Formation

Elevation: Ground KB

Section Plat

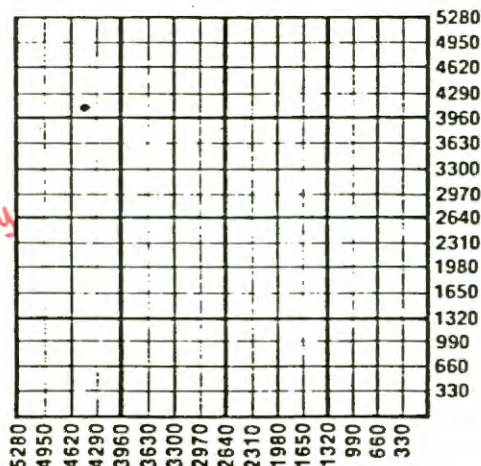

WATER SUPPLY INFORMATION

Source of Water: Commercial

Division of Water Resources Permit #

Groundwater \_\_\_\_\_ Ft North From Southeast Corn  
(Well) \_\_\_\_\_ Ft West From Southeast Corn

Sec Twp Rge  East  West

Surface Water \_\_\_\_\_ Ft North From Southeast Corn  
(Stream, Pond etc.) \_\_\_\_\_ Ft West From Southeast Corn

Sec Twp Rge  East  West

Other (explain) \_\_\_\_\_  
(purchased from city, R.W.D.#)

Disposition of Produced Water:  Disposal  Repressuring

Docket #

**INSTRUCTIONS:** This form shall be completed in duplicate and filed with the Kansas Corporation Commission, 200 Colorado Derby Building, Wichita, Kansas 67202, within 90 days after completion or recompletion of any well. Rules 82-3-130 and 82-3-107 apply.

Information on side two of this form will be held confidential for a period of 12 months if requested in writing and submitted with the form. See rule 82-3-107 for confidentiality in excess of 12 months.

A copy of all wireline logs and drillers time log shall be attached with this form. Submit CP-4 form with all plugged wells. Submit CP-111 form for temporarily abandoned wells.

**WELL-LOG**

**INSTRUCTIONS:** Show important tops and base of formations penetrated. Detail all cores. Report all drill stem tests giving interval tested, time tool open and closed, flowing and shut-in pressures, whether shut-in pressure reached s level, hydrostatic pressures, bottom hole temperature, fluid recovery, and flow rates if gas to surface during test. At extra sheet if more space is needed. Attach copy of log.

Drill Stem Tests Taken  Yes  No  
 Samples Sent to Geological Survey  Yes  No  
 Cores Taken  Yes  No

**Formation Description**  
 Log  Sample

Name	Top	Bottom
sd stone & clay	0	14
sd sh	14	23
ls	23	34
sh	34	40
ls	40	44
sh	44	48
sd	68	83
sd sh	83	127
ls	127	129
sh	129	134
ls	134	166
sh	166	224
ls	224	244
sh	244	252
ls	252	257
sh	257	290
ls	290	291
sh	291	354
ls	354	356
sh	356	419
coal	419	420
sh	420	422
coal	422	423
sh	423	425
oil sd	425	427
core #1	427	444
sh	444	596
coal	596	598
sh	598	604
coal	604	605
sh	605	671
Miss ls		

SEP 23 1985  
 State Geological Survey  
 WICHITA BRANCH

**CASING RECORD**  new  used

Report all strings set - conductor, surface, intermediate, production, etc.

Purpose of string	size hole drilled	size casing set (in O.D.)	weight lbs/ft	setting depth	type of cement	# sacks used	type and percent additives
Surface Casing	10 3/4	6 5/8		20'	beg.	6	

**PERFORATION RECORD**

shots per foot specify footage of each interval perforated

**Acid, Fracture, Shot, Cement Squeeze Record**

(amount and kind of material used) Depth

shots per foot	specify footage of each interval perforated	(amount and kind of material used)	Depth