

33-28-22-~~5~~

STATE CORPORATION COMMISSION OF KANSAS
OIL & GAS CONSERVATION DIVISION
WELL COMPLETION OR RECOMPLETION FORM
ACO-1 WELL HISTORY
DESCRIPTION OF WELL AND LEASE

Operator: License # 6766.....
Name NEW ENTERPRISES, INC......
Address 1111 S. MARYAUR.....
City/State/Zip FART. SEPT. KANSAS.....
66701

Purchaser FAIRWAY CARR.....

Operator Contact Person THOMAS L. DORRIS.....
Phone 316-222-6559.....

Contractor: License #
Name

Wellsite Geologist.....
Phone.....

Designate Type of Completion

☐ New Well ☒ Re-Entry ☐ Workover
☒ Oil ☐ SWD ☐ Temp Abd
☐ Gas ☐ Inj ☐ Delayed Comp.
☐ Dry ☐ Other (Core, Water Supply etc.)

If ~~OWO~~: old well info as follows:

Operator N/A.....
Well Name N/A.....
Comp. Date N/A..... Old Total Depth 394'

WELL HISTORY

Drilling Method:

☐ Mud Rotary ☐ Air Rotary ☒ Cable

N/A..... 1950.....
Spud Date Date Reached TD Completion Date

394'..... 1/2.....
Total Depth PBTD

Amount of Surface Pipe Set and Cemented at.....feet
Multiple Stage Cementing Collar Used? ☐ Yes ☐ No

If yes, show depth set.....feet

If alternate 2 completion, cement circulated
from.....feet depth to.....w/.....SX cmt
Cement Company Name
Invoice #

API NO. 15-.....
County CRAWFORD.....
S. 41/4 Sec 22 Twp 28 Rge 22 ☒ East ☒ West
2130... Ft North from Southeast Corner of Section
N. 870... Ft West from Southeast Corner of Section
(Note: Locate well in section plat below)


Lease Name WALSH..... Well # 1.....

Field Name WALSH.....

Producing Formation BARTLESVILLE.....

Elevation: Ground.....KB.....

Section Plat

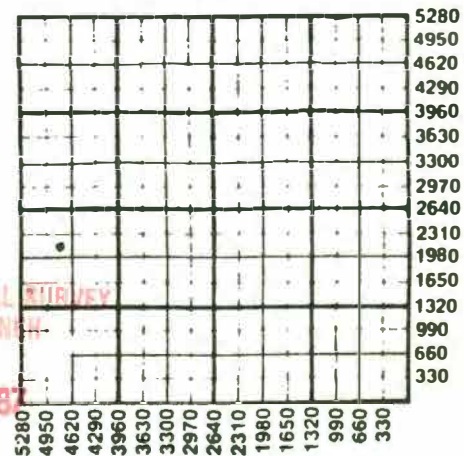

WATER SUPPLY INFORMATION

Disposition of Produced Water: ☐ Disposal
Docket # ☐ Repressuring

Questions on this portion of the ACO-1 call:

Water Resources Board (913) 296-3717

Source of Water:

Division of Water Resources Permit #.....

Groundwater.....Ft North from Southeast Corner
(Well)Ft West from Southeast Corner of
Sec Twp Rge East West

Surface Water.....Ft North from Southeast Corner
(Stream, pond etc).....Ft West from Southeast Corner
Sec Twp Rge East West

Other (explain).....
(purchased from city, R.W.D. #)

INSTRUCTIONS: This form shall be completed in triplicate and filed with the Kansas Corporation Commission, 200 Colorado Derby Building, Wichita, Kansas 67202, within 120 days of the spud date of any well. Rule 82-3-130, 82-3-107 and 82-3-106 apply.

Information on side two of this form will be held confidential for a period of 12 months if requested in writing and submitted with the form. See rule 82-3-107 for confidentiality in excess of 12 months.

One copy of all wireline logs and drillers time log shall be attached with this form. Submit CP-4 form with all plugged wells. Submit CP-111 form with all temporarily abandoned wells.

355-85-85

SIDE TWO

533321

Operator Name N.Y.W. Enterprises Inc. Lease Name W. 24 N. Well # 1

Sec. 33 Twp. 28 Rge. 22 ☒ East ☐ West County Crawford

WELL LOG

INSTRUCTIONS: Show important tops and base of formations penetrated. Detail all cores. Report all drill stem tests giving interval tested, time tool open and closed, flowing and shut-in pressures, whether shut-in pressure reached static level, hydrostatic pressures, bottom hole temperature, fluid recovery, and flow rates if gas to surface during test. Attach extra sheet if more space is needed. Attach copy of log.

Drill Stem Tests Taken ☐ Yes ☒ No
 Samples Sent to Geological Survey ☐ Yes ☒ No
 Cores Taken ☐ Yes ☒ No

Formation Description
☐ Log ☐ Sample

Name Top Bottom

*No Log
 Old Well*

Estimated Production Per 24 Hours	Oil	Gas	Water	Gas-Oil Ratio	Gravity
	Bbls	MCF	Bbls	CFPB	
	<i>1/2</i>		<i>1/2</i>	<i>50/50</i>	<i>28</i>

METHOD OF COMPLETION

Disposition of gas: ☒ Vented
☒ Sold
☐ Used on Lease

☒ Open Hole ☐ Perforation
☐ Other (Specify)

☒ Dually Completed
☐ Commingled

CASING RECORD ☐ New ☐ Used

Report all strings set-conductor, surface, intermediate, production, etc.

Purpose of String	Size Hole Drilled	Size Casing Set (In O.D.)	Weight Lbs/Ft.	Setting Depth	Type of Cement	#Sacks Used	Type and Percent Additives
<i>Tubing</i>		<i>2"</i>		<i>394'</i>	<i>To Top</i>		

PERFORATION RECORD

Shots Per Foot	Specify Footage of Each Interval Perforated	Acid, Fracture, Shot, Cement Squeeze Record (Amount and Kind of Material Used)	Depth
<i>N/A</i>	<i>N/A</i>	<i>N/A</i>	

TUBING RECORD	Size	Set At	Packer at	Liner Run	☐ Yes ☐ No
	<i>2"</i>		<i>394'</i>		

Date of First Production | Producing Method

1950's

☐ Flowing ☒ Pumping ☐ Gas Lift ☐ Other (explain)