

34-28-225

STATE CORPORATION COMMISSION OF KANSAS
OIL & GAS CONSERVATION DIVISIONWELL COMPLETION OR RECOMPLETION FORM
ACO-1 WELL HISTORY

DESCRIPTION OF WELL AND LEASE

Operator: License # 8018
 Name Lane Petroleum
 Address R.R. 1
Lane, Ks.
 City/State/Zip

Purchaser Square Deal

Operator Contact Person Jim Chambers
 Phone 913-869-3700

Contractor: License # 6913
 Name Casady Drilling

Wellsite Geologist.....
 Phone.....

Designate Type of Completion

☒ New Well ☐ Re-Entry ☐ Workover

☐ Oil ☐ SWD ☐ Temp Abd
☐ Gas ☒ Inj ☐ Delayed Comp.
☐ Dry ☐ Other (Core, Water Supply etc.)

If OWWO: old well info as follows:

Operator
 Well Name
 Comp. Date Old Total Depth.....

WELL HISTORY

Drilling Method:

☐ Mud Rotary ☒ Air Rotary ☐ Cable

8-28-84..... 8-29-84..... 9-19-84.....
 Spud Date Date Reached TD Completion Date
460.....
 Total Depth PBTD

Amount of Surface Pipe Set and Cemented at 20 feet
 Multiple Stage Cementing Collar Used? ☐ Yes ☐ No
 If yes, show depth set.....feet
 If alternate 2 completion, cement circulated
 from 0 feet depth to 20 w/ 5 SX cmt
see log reserved

API NO. 15- 037-21,226

County Crawford

NW NW SW
 Sec. 34 Twp. 28 Rge. 22 ☒ East ☐ West

1980 Ft North from Southeast Corner of Section
4620 Ft West from Southeast Corner of Section
 (Note: Locate well in section plat below)


Lease Name Giefer Well # 4-W

Field Name Hepler-Walnut

Producing Formation Bartlesville

Elevation: Ground.....KB.....

Section Plat

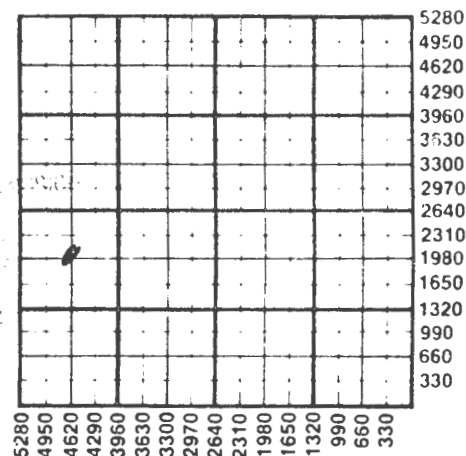

* WATER SUPPLY INFORMATION

Disposition of Produced Water: ☐ Disposal
 Docket # ☐ Repressuring

Questions on this portion of the ACO-1 call:

Water Resources Board (913) 296-3717

Source of Water:

Division of Water Resources Permit #.....

☐ Groundwater.....Ft North from Southeast Corner
 (Well)Ft West from Southeast Corner of
 Sec Twp Rge ☐ East ☐ West

☐ Surface Water.....Ft North from Southeast Corner
 (Stream, pond etc).....Ft West from Southeast Corner
 Sec Twp Rge ☐ East ☐ West

☐ Other (explain).....
 (purchased from city, R.W.D. #)

INSTRUCTIONS: This form shall be completed in duplicate and filed with the Kansas Corporation Commission, 200 Colorado Derby Building, Wichita, Kansas 67202, within 90 days after completion or recompletion of any well. Rule 82-3-130 and 82-3-107 apply.

Information on side two of this form will be held confidential for a period of 12 months if requested in writing and submitted with the form. See rule 82-3-107 for confidentiality in excess of 12 months.

One copy of all wireline logs and drillers time log shall be attached with this form. Submit CP-4 form with all plugged wells. Submit CP-111 form with all temporarily abandoned wells.

SIDE TWO

Operator Name Lane Petroleum Lease Name Giefer Well # 4-WSec. 34 Twp. 28 Rge. 22 ☒ East ☐ West County Crawford

WELL LOG

INSTRUCTIONS: Show important tops and base of formations penetrated. Detail all cores. Report all drill stem tests giving interval tested, time tool open and closed, flowing and shut-in pressures, whether shut-in pressure reached static level, hydrostatic pressures, bottom hole temperature, fluid recovery, and flow rates if gas to surface during test. Attach extra sheet if more space is needed. Attach copy of log.

Drill Stem Tests Taken ☐ Yes ☒ No
 Samples Sent to Geological Survey ☐ Yes ☒ No
 Cores Taken ☐ Yes ☒ No

Formation Description
☒ Log ☐ Sample

Name Top Bottom

Drill log attached

CASING RECORD ☒ New ☐ Used

Report all strings set-conductor, surface, intermediate, production, etc.

Purpose of String	Size Hole Drilled	Size Casing Set (in O.D.)	Weight Lbs/Ft.	Setting Depth	Type of Cement	#Sacks Used	Type and Percent Additives
Surface	9 7/8	6 1/4	8	20	Portland	5	
Production	2 x 7/8	2 7/8	7	435	Portland	60	

PERFORATION RECORD

Shots Per Foot	Specify Footage of Each Interval Perforated	Acid, Fracture, Shot, Cement Squeeze Record (Amount and Kind of Material Used)	Depth
1	391 - 398	6 sacks water and gel	398

TUBING RECORD Size Set At Packer at Liner Run ☐ Yes ☐ No

Date of First Production Producing Method

☐ Flowing ☐ Pumping ☐ Gas Lift ☐ Other (explain).....

LEASE NAME: GIEFER # 4-W
DATE DRILLED: AUG. 1984
COUNTY: CRAWFORD

API # 15-037-21,226
DESCRIP: 3300 FNL, 660 FWL
SW $\frac{1}{4}$ SEC. 34, T 28, R 22E

<u>THICKNESS</u>	<u>FORMATION</u>	<u>TOP</u>	<u>BOTTOM</u>	<u>REMARKS</u>
3	SOIL	0	3	20 FT. 6 $\frac{1}{4}$ " SURFACE SET W/ 4 SACKS PORTLAND
12	LIME	3	15	
65	SHALE	15	80	
45	LIME	80	125	
67	SHALE	125	192	
20	LIME	192	212	
13	SHALE	212	225	
98	SHALE	225	323	
3	LIME	323	326	
39	SHALE	326	365	
3	SLATE	365	368	
18	SHALE	368	386	
1	COAL	386	387	
3	SHALE DARK	387	390	
6	SAND	390	396	
1	SAND DARK	396	397	
2	SAND BROKEN	397	399	
3	LIME BROKEN	399	402	
58	SHALE	402	460	T.D.

COMPLETED WITH 2 7/8" TUBING TO DEPTH OF 435.2 FT. TWO CENTRALIZERS
USED.

OCT 3 1984

State Geological Survey
WICHITA BRANCH