

34-28-22

STATE CORPORATION COMMISSION OF KANSAS
OIL & GAS CONSERVATION DIVISION

WELL COMPLETION OR RECOMPLETION FORM
ACO-1 WELL HISTORY

DESCRIPTION OF WELL AND LEASE

Operator: License # 8018
Name Lane Petroleum
Address R.R. 1
Lane, Ks.
City/State/Zip

Purchaser Square Deal

Operator Contact Person Jim Chambers
Phone 913-869-3700

Contractor: License # 6913
Name Casady Drilling

Wellsite Geologist None
Phone

Designate Type of Completion

- New Well Re-Entry Workover
- Oil SWD Temp Abd
- Gas Inj Delayed Comp.
- Dry Other (Core, Water Supply etc.)

If OWWO: old well info as follows:
Operator
Well Name
Comp. Date Old Total Depth

WELL HISTORY

Drilling Method:
 Mud Rotary Air Rotary Cable

8-16-84 Mud Date 8-22-84 Date Reached TD 9-10-84 Completion Date

780 Total Depth PBTD

Amount of Surface Pipe Set and Cemented at 20 feet
Multiple Stage Cementing Collar Used? Yes No
If yes, show depth set feet
If alternate 2 completion, cement circulated from 0 feet depth to 20 w/.5 SX cmt

API NO. 15-15-037-21-227

County Crawford

SW 1/4 Sec. 34 Twp. 28 Rge. 22 East West

2640 Ft North from Southeast Corner of Section
4950 Ft West from Southeast Corner of Section
(Note: Locate well in section plat below)


Lease Name ~~XXXXX~~ Giefer Well # 1-WS

Field Name Hepler-Walnut

Producing Formation Arbuckle-Water

Elevation: Ground KB

Section Plat

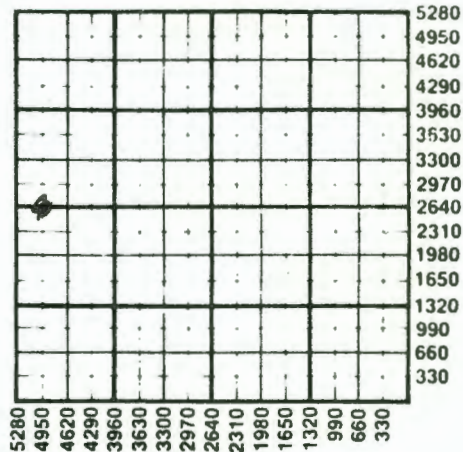

* WATER SUPPLY INFORMATION

Disposition of Produced Water: Disposal Repressuring
Docket #

Questions on this portion of the ACO-1 call:

Water Resources Board (913) 296-3717

Source of Water:
Division of Water Resources Permit #

Groundwater Ft North from Southeast Corner (Well) Ft West from Southeast Corner of Sec Twp Rge East West

Surface Water Ft North from Southeast Corner (Stream, pond etc) Ft West from Southeast Corner Sec Twp Rge East West

Other (explain) (purchased from city, R.W.D. #)

INSTRUCTIONS: This form shall be completed in duplicate and filed with the Kansas Corporation Commission, 200 Colorado Derby Building, Wichita, Kansas 67202, within 90 days after completion or recompletion of any well. Rule 82-3-130 and 82-3-107 apply. Information on side two of this form will be held confidential for a period of 12 months if requested in writing and submitted with the form. See rule 82-3-107 for confidentiality in excess of 12 months. One copy of all wireline logs and drillers time log shall be attached with this form. Submit CP-4 form with all plugged wells. Submit CP-111 form with all temporarily abandoned wells.

55-85-4E

SIDE TWO

Operator Name Lane Petroleum Lease Name Giefer Well # 1-WS

Sec. 34 Twp. 28 Rge. 22 East West County Crawford

WELL LOG

INSTRUCTIONS: Show important tops and base of formations penetrated. Detail all cores. Report all drill stem tests giving interval tested, time tool open and closed, flowing and shut-in pressures, whether shut-in pressure reached static level, hydrostatic pressures, bottom hole temperature, fluid recovery, and flow rates if gas to surface during test. Attach extra sheet if more space is needed. Attach copy of log.

Drill Stem Tests Taken [] Yes [X] No
Samples Sent to Geological Survey [] Yes [X] No
Cores Taken [] Yes [X] No

Formation Description [] Log [] Sample

Drill Log attached

Name Top Bottom

CASING RECORD [X] New [] Used
Report all strings set-conductor, surface, intermediate, production, etc.
Purpose of String Size Hole Size Casing Weight Setting Type of #Sacks Type and Percent
Surface 9 7/8" 7" 10 20 Portland 5
Production 6 1/4" 4 1/2" 9 650 Portland 70
PERFORATION RECORD
Shots Per Foot Specify Footage of Each Interval Perforated Acid, Fracture, Shot, Cement Squeeze Record
Date of First Production Producing Method [] Flowing [] Pumping [] Gas Lift [] Other (explain)

LEASE NAME: GIEFER # 1-WS
 DATE DRILLED: AUG. 1984
 COUNTY: CRAWFORD

API # 15-037-21,227
 DESCRIPT: 3960 FNL, 330 FWL
 SW $\frac{1}{4}$ SEC. 34, T. 28, R. 22E

THICKNESS	FORMATION	TOP	BOTTOM	REMARKS
18	SOIL	0	18	25 FT. 8 5/8" SURFACE
6	LIME	18	24	
56	SHALE	24	80	
4	LIME	80	84	
3	SLATE	84	87	
36	LIME	87	123	
4	SLATE	123	127	
63	SHALE	127	191	
21	LIME	191	212	
7	SHALE	212	219	
6	LIME	219	225	
99	SHALE	225	324	
2	LIME	324	326	
39	SHALE	326	365	
1	LIME	365	368	
14	SHALE	366	380	
4	LIGHT SANDY SHALE	380	384	
2	SHALE	384	386	
1	COAL	386	387	
1	SAND BROKEN	387	388	
5	SAND LIGHT	388	393	
4	SAND	393	397	
1	SAND LIMEY	397	398	
150	SHALE DARK	398	547	
5	SHALE LIGHT	547	552	
8	SAND BROKEN	552	560	NO SHOW
12	SHALE GRAY	560	572	
58	SHALE DARK	572	630	
27	LIME	630	657	MISSISSIPPI
7	BROWN CHAT	657	662	
51	LIME	662	713	
5	SHALE DARK	713	718	
52	LIME	718	780	T.D.

RECEIVED
 STATE CORPORATION COMMISSION

SEP 27 1984

CONSERVATION DIVISION
 Wichita, Kansas

GOOD WATER @ 750 FT. COMPLETED WITH 4 $\frac{1}{2}$ " TO DEPTH OF 660 FT.

WITH ARROW TYPE A PACKER. TWO CEMENT BASKETS AND TWO CENTRALIZERS.

CEMENTED WITH 60-40 POZ SALT ADDED CEMENT. GEL BEFORE.

OCT 3 1984
 State Geological Survey
 WICHITA BRANCH