

STATE CORPORATION COMMISSION OF KANSAS
OIL & GAS CONSERVATION DIVISION
WELL COMPLETION FORM
ACO-1 WELL HISTORY
DESCRIPTION OF WELL AND LEASE

1357
SIDE ONE

Operator: License # 3089

Name: Blue Top Oil Co.

Address RR #5 Box 148

City/State/Zip Ft. Scott, KS 66701

Purchaser: ENRON

Operator Contact Person: Liz Reusch

Phone (913) 242-5733

Contractor: Name: J. R. Burris Drilling

License: #5677

Wellsite Geologist: None

Designate Type of Completion

☒ New Well ☐ Re-Entry ☐ Workover

☐ Oil ☐ SWD ☐ Temp. Abd.

☐ Gas ☒ Inj ☐ Delayed Comp.

☐ Dry ☐ Other (Core, Water Supply, etc.)

If OWWO: old well info as follows:

Operator:

Well Name:

Comp. Date Old Total Depth

Drilling Method:

☐ Mud Rotary ☒ Air Rotary ☐ Cable

7-26-91 7-29-91 7-29-91

Spud Date Date Reached TD Completion Date

API NO. 15-037-21-444

County Crawford

Sec. 2 Twp. 28 Rge. 23 East West

3062 3060 Ft. North from Southeast Corner of Section

2675 2640 Ft. West from Southeast Corner of Section
(NOTE: Locate well in section plat below.)


Lease Name Holtman Well # I-1-91

Field Name Farlington

Producing Formation Peru

Elevation: Ground N/A KB

Total Depth 195 PBTD

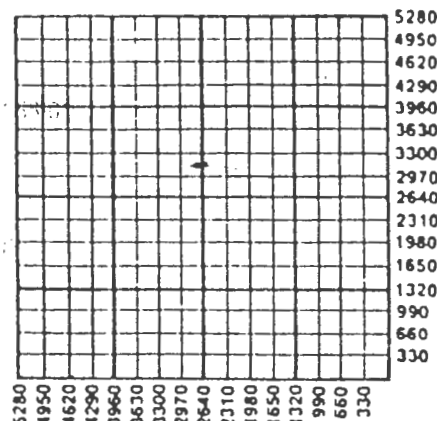

Amount of Surface Pipe Set and Cemented at 20 Feet

Multiple Stage Cementing Collar Used? Yes ☒ No

If yes, show depth set Feet

If Alternate II completion, cement circulated from 175

feet depth to surface w/ 30 sx cmt.

INSTRUCTIONS: This form shall be completed in triplicate and filed with the Kansas Corporation Commission, 200 Colorado Derby Building, Wichita, Kansas 67202, within 120 days of the spud date of any well. Rule 82-3-130, 82-3-107 and 82-3-106 apply. Information on side two of this form will be held confidential for a period of 12 months if requested in writing and submitted with the form. See rule 82-3-107 for confidentiality in excess of 12 months. One copy of all wireline logs and drillers time log shall be attached with this form. ALL CEMENTING TICKETS MUST BE ATTACHED. Submit CP-4 form with all plugged wells. Submit CP-111 form with all temporarily abandoned wells. Any recompletion, workover or conversion of a well requires filing of ACO-2 within 120 days from commencement date of such work.

All requirements of the statutes, rules and regulations promulgated to regulate the oil and gas industry have been fully complied with and the statements herein are complete and correct to the best of my knowledge.

Signature Elizabeth Reusch

Title Contact person Date 9/3/91

Subscribed and sworn to before me this 10th day of September, 1991.

Notary Public Jeanette Croucher

Date Commission Expires April 30, 1995

K.C.C. OFFICE USE ONLY

F Letter of Confidentiality Attached
C Wireline Log Received
C Drillers Timelog Received

Distribution

☒ KCC ☒ SWD/Rep ☐ NGPA
☒ KGS ☐ Plug ☒ Other (Specify)

SIDE TWO

Operator Name Blue Top Oil Co. Lease Name Holtman Well # I-1-91

Sec. 2 Twp. 28 Rge. 23 ☒ East County Crawford
☐ West

INSTRUCTIONS: Show important tops and base of formations penetrated. Detail all cores. Report all drill stem tests giving interval tested, time tool open and closed, flowing and shut-in pressures, whether shut-in pressure reached static level, hydrostatic pressures, bottom hole temperature, fluid recovery, and flow rates if gas to surface during test. Attach extra sheet if more space is needed. Attach copy of log.

Drill Stem Tests Taken (Attach Additional Sheets.)	<input type="checkbox"/> Yes	<input checked="" type="checkbox"/> No
Samples Sent to Geological Survey	<input type="checkbox"/> Yes	<input checked="" type="checkbox"/> No
Cores Taken	<input type="checkbox"/> Yes	<input checked="" type="checkbox"/> No
Electric Log Run (Submit Copy.)	<input type="checkbox"/> Yes	<input checked="" type="checkbox"/> No

Formation Description

☒ Log ☐ Sample

Name	Top	Bottom
Peru	175	195

CASING RECORD

☒ New ☐ Used

Report all strings set-conductor, surface, intermediate, production, etc.

Purpose of String	Size Hole Drilled	Size Casing Set (In O.D.)	Weight Lbs./Ft.	Setting Depth	Type of Cement	# Sacks Used	Type and Percent Additives
Surface	9"	7"		20	Class A	5	
Production	6.25"	4.5"		175	Class A	30	60-40-Pox

PERFORATION RECORD

Shots Per Foot	Specify Footage of Each Interval Perforated

Acid, Fracture, Shot, Cement Squeeze Record
(Amount and Kind of Material Used) Depth

[illegible]

TUBING RECORD

Size	Set At	Packer At
------	--------	-----------

Liner Run ☐ Yes ☐ No

Date of First Production	Producing Method
	<input type="checkbox"/> Flowing <input type="checkbox"/> Pumping <input type="checkbox"/> Gas Lift <input type="checkbox"/> Other (Explain) Injection well

Estimated Production Per 24 Hours	Oil	Bbls.	Gas	Mcf	Water	Bbls.	Gas-Oil Ratio	Gravity
--------------------------------------	-----	-------	-----	-----	-------	-------	---------------	---------

Disposition of Gas:

METHOD OF COMPLETION

Production Interval

☐ Vented ☐ Sold ☐ Used on Lease
(If vented, submit ACO-18.)

☐ Open Hole ☐ Perforation ☐ Dually Completed ☐ Commingled
☐ Other (Specify) _____