

4-28-235

STATE CORPORATION COMMISSION OF KANSAS
OIL & GAS CONSERVATION DIVISION
WELL COMPLETION OR RECOMPLETION FORM
ACO-1 WELL HISTORY

DESCRIPTION OF WELL AND LEASE

Operator: license # 6086
name The Production Team
address P. O. Box 785
Independence,
City/State/Zip Kansas 67301

Operator Contact Person Alexander Davie
Phone 1-331-2835

Factor: license # 5493
name Pat Chase-Chase Drilling

Wellsite Geologist None
Phone N/A
HASER Eureka Crude

Designate Type of Completion
 New Well Re-Entry Workover
 Oil SWD Temp Abd
 Gas Inj Delayed Comp.
 Dry Other (Core, Water Supply etc.)

if OWWO: old well info as follows:
Operator N/A
Well Name
Comp. Date Old Total Depth

WELL HISTORY

Drilling Method: Mud Rotary Air Rotary Cable
1/28/84 1/28/84 8/28/84
Spud Date Date Reached TD Completion Date
184
Depth PBTD
Amount of Surface Pipe Set and Cemented at 20 feet
Multiple Stage Cementing Collar Used? Yes No
If Yes, Show Depth Set feet

Alternate 2 completion, cement circulated
from 0 feet depth to 20 w/ 8 SX cmt

APINO. 15-037-21, 035
County Crawford

NE/4 (location) Sec 4 Twp 28 Rge 23 F

3563 Ft North from Southeast Corner of
1732 Ft West from Southeast Corner of
(Note: locate well in section plat below)


Lease Name Pearson Well# 48

Field Name ?

Producing Formation Peru

Elevation: Ground ? KB -

Section Plat

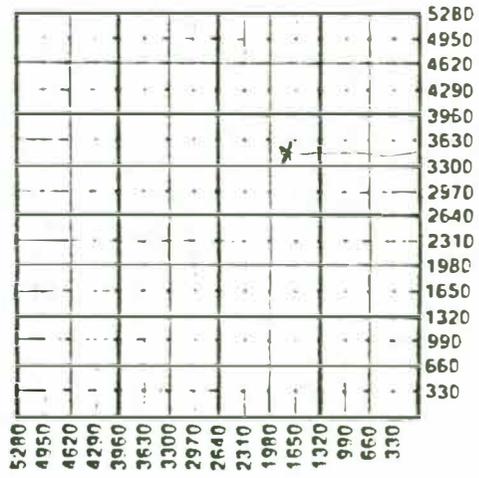

WATER SUPPLY INFORMATION

Source of Water:
Division of Water Resources Permit # N/A
 Groundwater (Well) Ft North From Southeast Corn
Ft West From Southeast Cor
Sec Twp Rge East West
 Surface Water (Stream, Pond etc.) Ft North From Southeast Corn
Ft West From Southeast (
Sec Twp Rge East West
 Other (explain) _____
(purchased from city, R.W.D.#)

Disposition of Produced Water: Disposal Repressuring
Docket # N/A

INSTRUCTIONS: This form shall be completed in duplicate and filed with the Kansas Corporation Commission, 200 Colorado Derby Bui
Wichita, Kansas 67202, within 90 days after completion or recompletion of any well. Rules 82-3-130 and 82-3-107 apply.

Information on side two of this form will be held confidential for a period of 12 months if requested in writing and submitted with the form. See rule 82-

One copy of all wireline logs and drillers time log shall be attached with this form. Submit CP-4 form with all plugged wells. Submit CP-111 form all temporarily abandoned wells.

JAN 3 1985

All requirements of the statutes, rules, and regulations promulgated to regulate the oil and gas industry have been fully complied with and the statements herein are complete and correct to the best of my knowledge.

Signature Sam Warner
 Title Agent
 Date 10/25/84

State Geological Survey
 WICHITA BRANCH

K.C.C. OFFICE USE ONLY

F Letter of Confidentiality Attached
 C Wireline Log Received
 C Drillers Timelog Received

Distribution

KCC SWD/Rep NGPA
 KGS Plug Other
 (Specify)

Subscribed and sworn to before me this 25 day of Oct 1984
 Notary Public Priscilla P. Davies
 Date Commission Expires 10/8/88

Form ACO-1 (7-84)

CASING RECORD <input checked="" type="checkbox"/> new <input type="checkbox"/> used							
Report all strings set - conductor, surface, intermediate, production, etc.							
Purpose of string	size hole drilled	size casing set (m O.D.)	weight lbs/ft	setting depth	type of cement	# sacks used	type and percent additives
Production		2 7/8		approx. 20'	Portland	8	
Surface		6 5/8		" " 200'	Portland	25	

PERFORATION RECORD		Acid, Fracture, Shot, Cement Squeeze Record	
shots per foot	specify footage of each interval perforated	(amount and kind of material used)	Depth
	No.	Sand & Rock Salt	Approx. 180-197'

OPEN HOLE Liner Run Yes No

Date of First Production	Producing method <input type="checkbox"/> flowing <input checked="" type="checkbox"/> pumping <input type="checkbox"/> gas lift <input type="checkbox"/> Other (explain)				
Estimated Production Per 24 Hours	Oil	Gas	Water	Gas-Oil Ratio	Gravity
	Approx. 2 bbls.	0 MCF	20% Bbls	0 CFPB	32-34

Disposition of gas: vented sold used on lease

METHOD OF COMPLETION
 open hole perforation other (specify)

PRODUCTION INTERVAL
66666

Dually Completed. Commingled

4-58-53E

