

3-28-3E KC 9/25/84

SIDE ONE

STATE CORPORATION COMMISSION OF KANSAS  
OIL & GAS CONSERVATION DIVISION

WELL COMPLETION OR RECOMPLETION FORM  
ACO-1 WELL HISTORY

DESCRIPTION OF WELL AND LEASE

Operator: License # 5476  
Name DNB Drilling, Inc.  
Address 535 N. Oliver  
City/State/Zip Wichita, Ks. 67208

Purchaser NA

Operator Contact Person James Donelson Jr.  
Phone (316) 687-5471

Contractor: License # 5420  
Name White and Ellis Drilling, Inc

Wellsite Geologist Kenneth Johnson  
Phone (316) 269-9001

Designate Type of Completion

- New Well
- Re-Entry
- Workover
- Oil
- Gas
- Dry
- SWD
- Inj
- Other (Core, Water Supply etc.)
- Temp Abd
- Delayed Comp.

If OWWO: old well info as follows:

Operator  
Well Name  
Comp. Date Old Total Depth

WELL HISTORY

Drilling Method:

- Mud Rotary
- Air Rotary
- Cable

.9-.19-84..	.9-.25-84....	.9-.25-84....
Spud Date	Date Reached TD	Completion Date
...30.75....	.....	.....
Total Depth	PBTD	

Amount of Surface Pipe Set and Cemented at.....feet  
Multiple Stage Cementing Collar Used?  Yes  No  
If yes, show depth set.....feet  
If alternate 2 completion, cement circulated from.....feet depth to.....w/.....SX cmt

API NO. 15-015-22,601

County Butler

NE NW SW 3 28 3  East  
Sec Twp Rge  West

2210 Ft North from Southeast Corner of Section  
4290 Ft West from Southeast Corner of Section

(Note: Locate well in section plat below)


Lease Name Trabue Well # 1

Field Name

Producing Formation NA

Elevation: Ground 1275 KB 1280

Section Plat

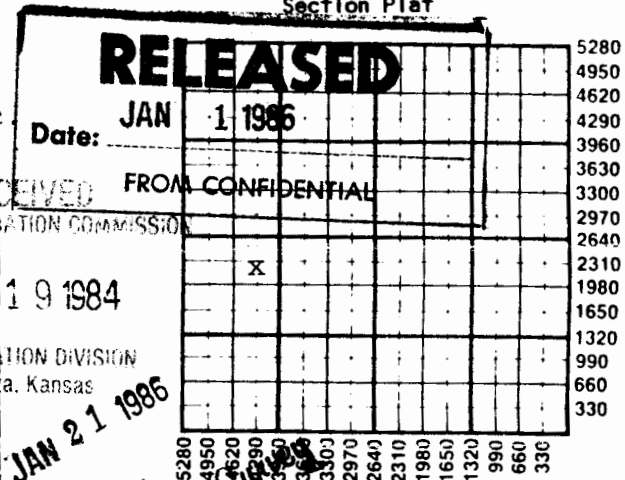

OCT 19 1984

CONSERVATION DIVISION  
Wichita, Kansas

JAN 21 1986

State Corporation Commission  
WICHITA BRANCH

WATER SUPPLY INFORMATION

Disposition of Produced Water:  Disposal  Re-pressuring

Questions on this portion of the ACO-1 call:

Water Resources Board (913) 296-3717

Source of Water: Division of Water Resources Permit # NA

Groundwater.....Ft North from Southeast Corner (Well) .....Ft West from Southeast Corner of Sec Twp Rge  East  West

Surface Water.....Ft North from Southeast Corner (Stream, pond etc).....Ft West from Southeast Corner Sec Twp Rge  East  West

Other (explain) Hauled by contractor (purchased from city, R.W.D. #)

INSTRUCTIONS: This form shall be completed in duplicate and filed with the Kansas Corporation Commission, 200 Colorado Derby Building, Wichita, Kansas 67202, within 90 days after completion or recompletion of any well. Rule 82-3-130 and 82-3-107 apply.

Information on side two of this form will be held confidential for a period of 12 months if requested in writing and submitted with the form. See rule 82-3-107 for confidentiality in excess of 12 months.

One copy of all wireline logs and drillers time log shall be attached with this form. Submit CP-4 form with all plugged wells. Submit CP-111 form with all temporarily abandoned wells.

Operator Name DNB Drilling, Inc Lease Name Trabue Well # 1

Sec. 3 Twp. 28 Rge. 3  East  West County Butler

WELL LOG

INSTRUCTIONS: Show important tops and base of formations penetrated. Detail all cores. Report all drill stem tests giving interval tested, time tool open and closed, flowing and shut-in pressures, whether shut-in pressure reached static level, hydrostatic pressures, bottom hole temperature, fluid recovery, and flow rates if gas to surface during test. Attach extra sheet if more space is needed. Attach copy of log.

Drill Stem Tests Taken  Yes  No  
 Samples Sent to Geological Survey  Yes  No  
 Cores Taken  Yes  No

Formation Description  
 Log  Sample

DST #1 3031-3046 30-45 30-45  
 IFP 143-373 FFP 373-511  
 ISIP 1043# FSIP 1024#  
 Rec. 820' SW


Name	Top	Bottom
Hebner	1711	
Iatan	1919	
Stalnaker	1952	
Lansing	1958	
Kansas City	2302	
B/Kansas City	2507	
Mississippian	2807	
Kinderhook	2980	
Simpson Sand	3041	

CASING RECORD <input checked="" type="checkbox"/> New <input type="checkbox"/> Used							
Report all strings set-conductor, surface, intermediate, production, etc.							
Purpose of String	Size Hole Drilled	Size Casing Set (in O.D.)	Weight Lbs/Ft.	Setting Depth	Type of Cement	#Sacks Used	Type and Percent Additives
Surface	12 1/4	8 5/8	23.5	206	Class A	140	3% cc
.....	.....	.....	.....	.....	.....	.....	.....
.....	.....	.....	.....	.....	.....	.....	.....
.....	.....	.....	.....	.....	.....	.....	.....

PERFORATION RECORD		Acid, Fracture, Shot, Cement Squeeze Record	
Shots Per Foot	Specify Footage of Each Interval Perforated	(Amount and Kind of Material Used)	Depth
.....	.....	.....	.....
.....	.....	.....	.....
.....	.....	.....	.....
.....	.....	.....	.....

TUBING RECORD			
Size	Set At	Packer at	Liner Run <input type="checkbox"/> Yes <input type="checkbox"/> No
.....	.....	.....	.....

Date of First Production	Producing Method
.....	<input type="checkbox"/> Flowing <input type="checkbox"/> Pumping <input type="checkbox"/> Gas Lift <input type="checkbox"/> Other (explain).....

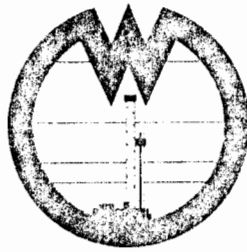

2-28-84

4P

WHITE

AND ELLIS DRILLING, Inc.

DRILLERS LOG

OPERATOR: DNB Drilling, Inc.  
 535 N. Oliver  
 Wichita, Kansas 67208

CONTRACTOR: White & Ellis Drilling, Inc., 401 E. Douglas, Suite 500,  
 Wichita, Ks. 67202

Lease Name Trabue Well No. #1

Sec. 3 T. 28S R. 3E Spot NE NW SW

County Butler State Kansas Elevation \_\_\_\_\_

Casing Record:

Surface: 8 5/8 @ 213' with 140 sx. 3% cc

Production: \_\_\_\_\_ @ \_\_\_\_\_ with \_\_\_\_\_ sx.

Type Well: D & A Total Depth 3075'

Drilling Commenced 9-19-84 Drilling Completed 9-26-84

Formation	From	To	Tops
Cellar	0	7	Mississippi - 2809
Shale, Lime	7	220	Simpson - 3040
Shale	220	255	
Shale, Lime	255	1800	
Sand, Shale	1800	1877	
Shale	1877	1919	
Lime	1919	1927	
Shale, Sand	1927	2031	
Shale, Lime	2031	2225	
Shale	2225	2302	
Lime	2302	2495	
Lime, Shale	2495	2809	
Lime	2809	2985	
Lime, Shale	2985	3040	
Sand, Shale	3040	3075	

JAN 21 1985  
 State Geological Survey  
 WICHITA BRANCH