

KANSAS

Butler County

FORM 51 IOM 12-46 PETROL

FORM 282-A  
5M 12-46 PETROL

KANSAS

Butler ✓

Sec. 14 Twp. 28 R. 3-E

Section 14 Township 28 Range 3-E

Well No. #1 Dennett Farm

Well No. 1 Dennett

Talbot et al Company


Company Talbot et al

Miscellaneous

Miscellaneous

NORTH

NORTH

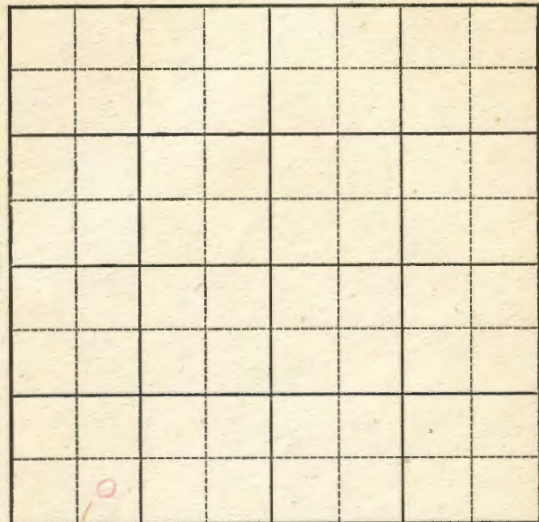

SOUTH


\_\_\_\_\_ Ft. from N. Line

330 Ft. from S. Line

\_\_\_\_\_ Ft. from E. Line

990 Ft. from W. Line

SE SW SW

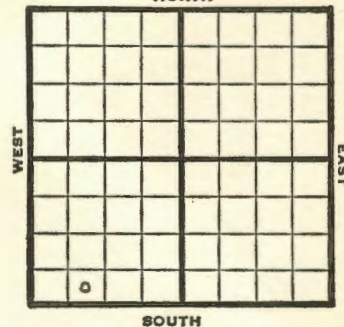

SOUTH

1947

Elev. 1320'

REPORT

7/9

R U R

7/16

Kinderhook 2895'

T.D. 2960'

5" @ 2960'

8/6

Simp. 2985'

8/13

" "

8/20

" "

8/27

" "

9/3

" "

9/10

Simp. 2988'

5" @ 2960'

15 qts.

Pump 16 pot

41.0 Gr.

TD 3005'

COMPLETED

Map No. 12 Sec. 14 Twp. 28 R. 3E

Well No. 1 Dennett

Talbot etal. Company

COMPLETE Contractor

SE SW SW

E1, N1/4  
SECTION PLAT


Ft. from N. Line

330 Ft. from S. Line

Ft. from E. Line

990 Ft. from W. Line

Butler County

Location \_\_\_\_\_

Rig up \_\_\_\_\_

Drilling and Remarks:

*Shut 2988*  
*5-26-46*  
*137 1/2*  
*Pump Test*  
*412 1/2*

RECORD

Cased \_\_\_\_\_ in, \_\_\_\_\_ ft.

Sand \_\_\_\_\_

Gas \_\_\_\_\_

Oil \_\_\_\_\_

Total Depth 3005

PRODUCTION

1st 24 hrs. Nat. \_\_\_\_\_

1st 24 hrs. after shot \_\_\_\_\_

Gas \_\_\_\_\_ Cu. Ft.

Dry Hole \_\_\_\_\_

Abandoned \_\_\_\_\_

Date

SEP 10 1947

19

S. J. LEWIS

Scout

Map No. \_\_\_\_\_ Sec. 14 Twp. 28 R. 3E

Well No. 1 Dennett

Talbot etal. Company

FIRST REPORT Contractor

SE SW SW

SECTION PLAT


Ft. from N. Line

330 Ft. from S. Line

Ft. from E. Line

990 Ft. from W. Line

Butler County

Location \_\_\_\_\_

Rig up \_\_\_\_\_

Drilling and Remarks:

R U R

RECORD

Cased \_\_\_\_\_ in, \_\_\_\_\_ ft.

Sand \_\_\_\_\_

Gas \_\_\_\_\_

Oil \_\_\_\_\_

Total Depth \_\_\_\_\_

PRODUCTION

1st 24 hrs. Nat. \_\_\_\_\_

1st 24 hrs. after shot \_\_\_\_\_

Gas \_\_\_\_\_ Cu. Ft.

Dry Hole \_\_\_\_\_

Abandoned \_\_\_\_\_

Date

JUL 9 1947

19

S. J. LEWIS

Scout