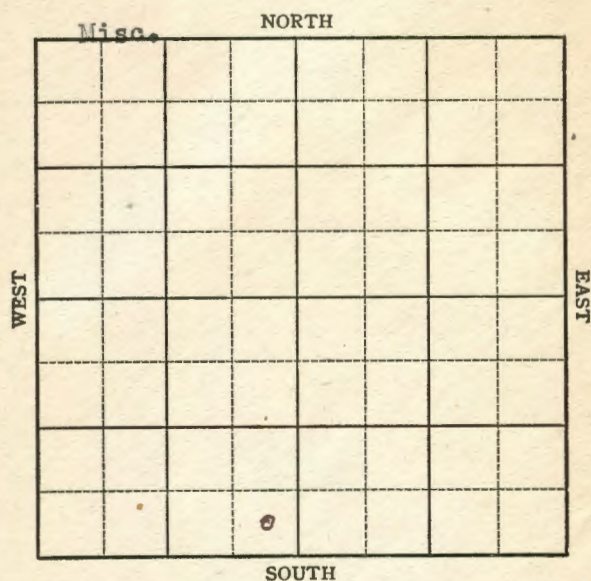


KANSAS

Butler

Section 14 Township 28 Range 3EWell No. 1 LackeyCompany J. P. Gaty

Butler KANSAS ✓


Sec. 14 Twp. 28 R. 3EWell No. #1 Lackey FarmJ. P. Gaty Company

Misc.

Ft. from N. Line

330 Ft. from S. Line330 Ft. from E. Line

Ft. from W. Line

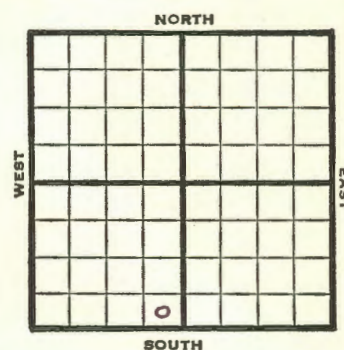

SE SW

1947

Elev. 1333

REPORT

7/23

Location

7/28

8" @ 155'
WOO

8/6

Drlg 630'

8/13

TD 2960
5" @ 2960

8/20

"

8/27

"

9/3

KC 2305
Mississippi 2773'

9/10

5" @ 2980'

9/17

"

9/24

Pump 50 bbls oil a day

10/1

"

10/8

Simpson 2993
5" @ 2980'
Pump 60 Pot.
TD 3007
Gravity 40

COMPLETED


Map No. 12 Sec. 14 Twp. 28 R. 3EWell No. 1 LackeyJ. P. Gatty Company

COMPLETE

Contractor

SE SW

SECTION PLAT

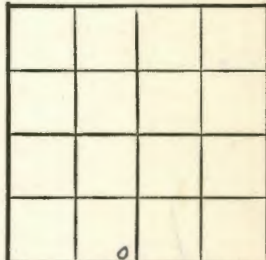 Ft. from N. Line330 Ft. from S. Line330 Ft. from E. Line Ft. from W. Line

Butler County

Location

Rig up

Drilling and Remarks:

Comp 2998
3000Pump 60 ft40 ft

Date

OCT 8 1947 19

S. J. LEWIS

Scout

RECORD

Cased in., ft.Sand Gas Oil Total Depth 3007

PRODUCTION

1st 24 hrs. Nat. 1st 24 hrs. after shot Gas Cu. Ft.Dry Hole Abandoned

Kansas


Map No. Sec. 14 Twp. 28 R. 3EWell No. 1 LackeyJ. P. Gatty Company

FIRST REPORT

Contractor

SE SW

SECTION PLAT

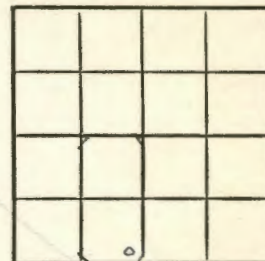 Ft. from N. Line330 Ft. from S. Line330 Ft. from E. Line Ft. from W. Line

Butler County

Location XRig up

Drilling and Remarks:

RECORD

Cased in., ft.Sand Gas Oil Total Depth

PRODUCTION

1st 24 hrs. Nat. 1st 24 hrs. after shot Gas Cu. Ft.Dry Hole Abandoned

Date

OCT 23 1947

19

S. J. LEWIS

Scout