


Map No. K Sec. 14 Twp. 28 R. 3
 Well No. Swindell Farm
Shryock et al. Company

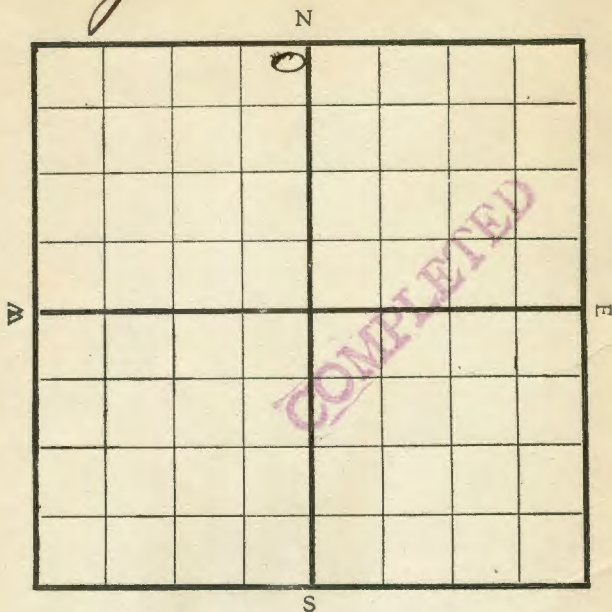

Location NENE NW
 Drilling Remarks:

Rig Up
 Drilling Remarks:

RECORD

Cased _____ in. _____ ft.
 Sand _____
 Gas _____
 Oil _____
 Total Depth _____

PRODUCTION

1st 24 hrs. Nat. _____
 1st 24 hrs. after shot _____
 Gas _____ cu. ft.
 Dry Hole _____
 Abandoned _____


Map No. K Sec. 14 Twp. 28 R. 3
 Well No. Swindell Farm
Shryock et al. Company

200 Ft. from N. Line

_____ Ft. from S. Line

200 Ft. from E. Line

_____ Ft. from W. Line

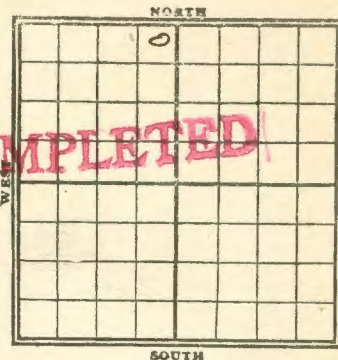

REPORT **FIRST REPORT**

1800

3/23

Rig up

4/2

Shut

9

✓ + SD

5/4

1800

6/8

seg 2420'

14

Dry + Aban 2780

Light show.

K12 KANSAS MAP No. 14 Sec. 14 TWP. 28 S. R. 3 E.

WELL No. 1 Swindell

Shryock et al COMPANY

CONTRACTOR

ABANDONED

SECTION PLAT

	9	

Ft. FROM N. LINE

Ft. FROM S. LINE

Ft. FROM E. LINE

Ft. FROM W. LINE

LOCATION

RIG UP

DRILLING AND REMARKS:

RECORD

CASED _____ IN. _____ FT.

SAND _____

GAS _____

OIL _____

TOTAL DEPTH 2780

PRODUCTION

1ST 24 HRS. NAT. _____

1ST 24 HRS. AFTER SHOT _____

GAS _____ CU. FT.

DRY HOLE _____

ABANDONED _____

DATE

6/16 1920 SCOUT

Map No. K12 Sec. 14 Twp. 28 R. 3

Well No. 1 Swindell

Shryock et al COMPANY

CONTRACTOR

SECTION PLAT

	0	

200 Ft. from N. Line

Ft. from S. Line

200 Ft. from E. Line

Ft. from W. Line

COMPLETED

Location

Rig up

Drilling and Remarks:

Light show
2575-90

RECORD

CASED _____ in. _____ ft.

SAND _____

GAS _____

OIL _____

Total Depth _____

PRODUCTION

1st 24 hrs. Nat. _____

1st 24 hrs. after shot _____

GAS _____ CU. FT.

Dry Hole 2780

Abandoned _____

Date

6/14 1920

Pyle

Scout