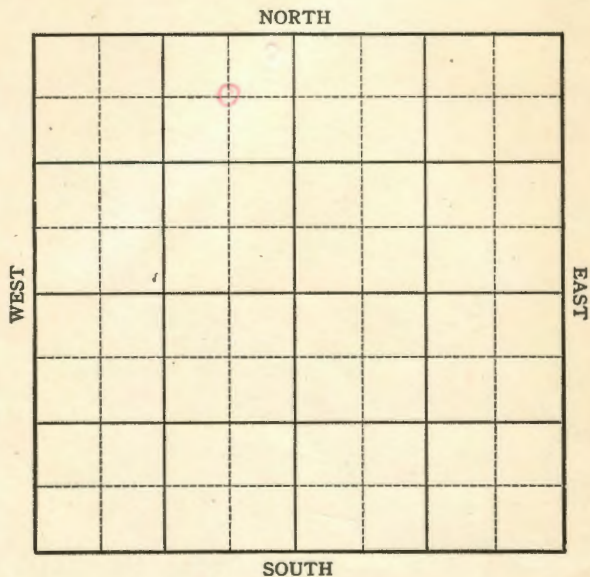


KANSAS

Butler County

FORM 51 5M 6-46 PETROL


Section 22 Township 28 Range 3-EWell No. #1 Windell (Swindell)Company Alter et alFORM 252-A
5M 6-46 PETROL

KANSAS

Butler County

Sec. 22 Twp. 28 R. 3EWell No. #1 Windell FarmAlter et al Company

Miscellaneous

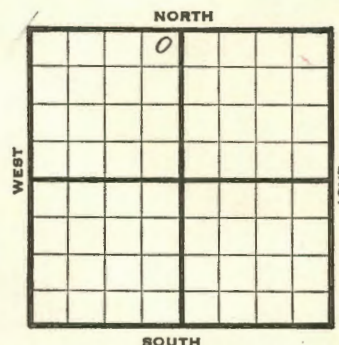330 Ft. from N. Line Ft. from S. Line330 Ft. from E. Line Ft. from W. Line

NE NW

1946 Elev. 317' 1338' REPORT

8/14 Machine
 8/20 15" @ 172'
 Drlg 620'
 8/27 13" @ 1080
 Drlg 1250'
 9/5 10" @ 1982
 Drlg 2100'
 9/10 6" @ 2483'
 Drlg 2515'
 9/18 Miss 2833'
 Drlg 2990'
 9/25 Arb 3160'
 TD 3178'

ABANDONED

KANSAS

Kansas

Pool Name MiscellaneousMap No. 12 Sec. 22 Twp. 28 R. 3EWell No. 1 Windell

Alter etal.

Company

ABANDONED

Contractor

NE NW

SECTION PLAT

330 Ft. from N. Line

Ft. from S. Line

330 Ft. from E. Line

Ft. from W. Line

Butler County

Location

RECORD

Cased in, ft.

Sand

Gas

Oil

Total Depth 317

PRODUCTION

1st 24 hrs. Nat.

1st 24 hrs. after shot

Gas Cu. Ft.

Dry Hole

Abandoned

Date

SEP 25 1946

19

S. J. LEWIS Scout

KANSAS

Kansas Pool Name MiscellaneousMap No. 12 Sec. 22 Twp. 28 R. 3EWell No. 1 Windell

Alter etal.

Company

FIRST REPORT

Contractor

NE NW

SECTION PLAT

330 Ft. from N. Line

Ft. from S. Line

330 Ft. from E. Line

Ft. from W. Line

Butler County

Location

RECORD

Cased in, ft.

Sand

Gas

Oil

Total Depth

PRODUCTION

1st 24 hrs. Nat.

1st 24 hrs. after shot

Gas Cu. Ft.

Dry Hole

Abandoned

Date

AUG 14 1946 19

S. J. LEWIS Scout