


✓
↑

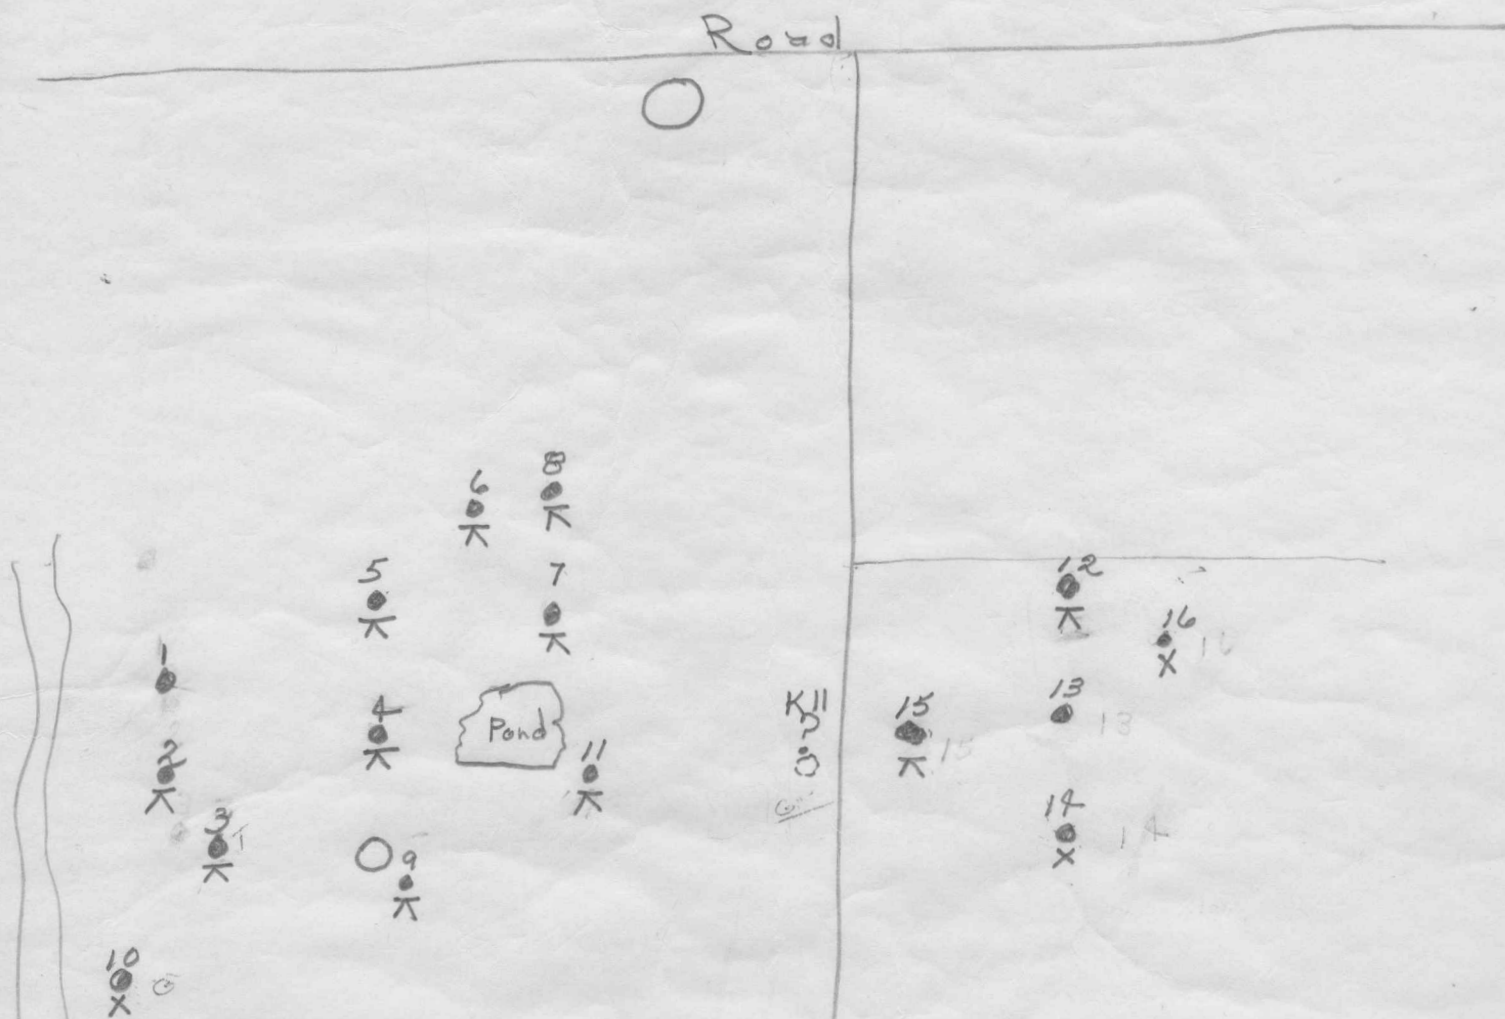

Relative Location of wells for Royal Oak

Map Key (KGS-DRL)

Well

Logging Speed 25' min

10 ~~4~~ 5 1/2" Zero Top of DP 17" AGL

J-14 R.D. 430 9"

T.D. 431 7"

Snat Sit 10-3 --- 1.0
2 Div L

T.C 3'

2 2" Zero top of 4 1/2" S.P. 10" AGL.

H-8

R.D. 421.5"

T.D. 422.3"

10-3 .6

2 L

3 2" top 4 1/2" S.P. 8" AGL

H-10

R.D. 422.3

T.D. 423.1

4 5 1/2" Top 5 1/2" collar 6" AGL

J-13

R.D. 419 - 434

T.D. 419-10" 434'0"

Tool #2

corrected meas whal

5 2" Zero top 5 1/2" collar 10" AGL.

J-6

R.D. 429-8"

T.D. 430-6"

Tool #2

6. 2" zero top 2" 20" AGL.

K-5

R.D. 434

T.D. 434-10"

2" line pipe

7 2" zero top 2" 19' AGL.

K-7

R.D. 429.2

T.D. 430

8. 2" top 4" 0' AGL.

L-9

R.D. 421-9

T.D. 422-7

Tues

9. $4\frac{1}{2}$ Top of D.P. 0" AGL.
I-11 R.D. 427
T.D. 427-10 10-4 - $\frac{2}{3}$.6

* 10. $4\frac{1}{2}$ Top of D.P. 11" AGL.
G-11 R.D. 424.9
T.D. 425.7

11 $4\frac{1}{2}$ Top D.P. 4" AGL.
R.D. 425
T.D. 425-10"

12. ~~$4\frac{1}{2}$~~ $5\frac{1}{2}$ Top DP 6" AGL
R.D. 422-8
T.D. 423-6

13 $4\frac{1}{2}$ Top DP 0" AGL
RD 385-2
TD 386

14 $2''$ Top of DP 6" AGL
I-10 RD 449-7
TD 450-5

15 $4\frac{1}{2}$ Top DP 8" AGL
RD 427-10 TD 428-8

16 - Unknown

2"

DP

9" AGL

RD 394-10

TD 355-8