

Beaumont Oil & Gas Syndicate.

Loc.- NE cor SW₄

Dr. Comm.-


Dr. Comp.-

Init. Prod.-

Elev.-

Collinson #1
Sec. 35-28-7
Butler County, Kansas.

24097

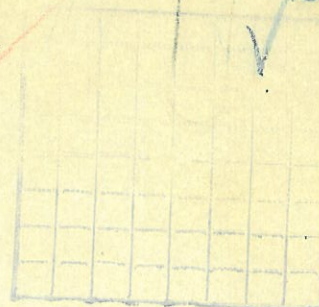

CASING RECORD

Shale gray soft	15	267
Lime white hard	20	287
Lime white hard	20	307
Shale gray soft	10	317
Red rock	8	325
Shale gray hard	20	345
Lime white hard	10	355
Shale blue soft	20	375
Lime broken	35	410
Mud black	83	493
Lime gray hard	4	507
Shale blk hard	68	585
Lime gray hard	5	570
Shale gray hard	70	640
Sandy lime soft	10	650
Shale gray soft	75	725
Lime white hard	4	789
Shale gray soft	6	755
Lime white hard	15	750
Shale gray hard	35	785
Lime white hard	20	805
Shale gray hard	15	820
Lime blue hard	12	832
Shale blue soft	28	850
Sand water soft	6	866
Shale soft	35	901
Lime blue hard	15	916
Shale blue hard	10	926
Lime white hard	5	921
Shale blue hard	10	941
Lime white hard	13	954
Shale gray soft	20	974
Lime blue hard	10	984
Shale blue hard	10	994
Lime white soft	10	1004
Shale gray soft	20	1084
Lime gray hard	5	1039
Shale blue soft	10	1049

Lime blue soft	3	1052
Shale black soft	20	1072
Lime gray hard	64	1138
Sand light	10	1146
Lime white hard	5	1151
Shale gray	27	1178
Lime white soft	3	1181
Shale gray soft	20	1201
Lime white hard	30	1231
Shale blue soft	10	1241
Lime gray hard	50	1291
Sand light	10	1301
Shale black soft	10	1311
Lime gray soft	5	1316
Shale gray hard	30	1346
Lime white hard	10	1356
Shale gray soft	20	1376
Lime white hard	20	1396
Shale black hard	40	1436
Lime white hard	5	1441
Shale gray soft	24	1465
Lime gray hard	30	1545
Lime gray hard	20	1565
Sand water	20	1585
Shale gray hard	5	1590
Lime white hard	15	1605
Sand white	35	1640
Shale gray hard	70	1710
Lime white hard	20	1730
Shale blue hard	20	1750
Lime white hard	110	1860
Sand water soft	5	1865
Sand hard	20	1885
Lime gray hard	105	1990
Shale gray hard	10	2000
Lime gray hard	5	2005
Shale gray hard	10	2015
Lime gray soft	3	2018
Shale blue soft	30	2048
Lime gray soft	5	2053
Shale gray hard	20	2053
Lime gray soft	5	2078
Shale gray soft	10	2088
Lime white hard	80	2158
Sandy lime white soft	63	2251

Shale gray hard	10	2261
Lime gray soft	10 Oil	2271
Sand oil	65 showing	2326
Shale black soft	95	2421
Lime gray hard	8	2429
Shale black hard	25	2454
Lime white hard	12	2466
Shale blue hard	27	2493
Coal black	10	2502
Lime gray hard	20	2523
Slate black hard	20	2543
Lime gray hard	5	2548
Shale black hard	5	2553
Lime broken gray	23	2576
Shale black hard	67	2631
Lime blue hard	3	2634
Shale black hard	14	2648
Coal black hard	12	2660
Lime gray hard	18	2678
Shale black hard	112	2790
Slate gray hard	40	2830
Sandy lime	75	2905
2 ft streak at intervals		
Shale black sandy	35	2940
Sand white	55	2995
Lime white hard	7	3002 T.D.

2995
1342
1453