


WELL PLUGGING RECORD

Give All Information Completely
Make Required Affidavit
Mail or Deliver Report to:
Conservation Division
State Corporation Commission
P. O. Box 17027
Wichita, Kansas 67217
NORTH

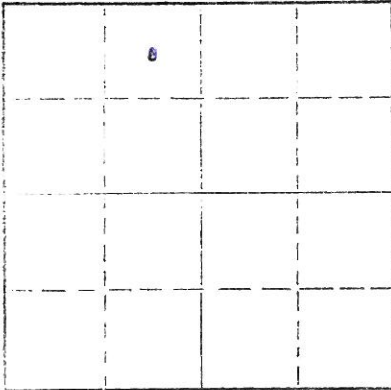

Locate well correctly on above Section Plat

Elk County, Sec. 34 Twp. 29 Rge. 10 (E) (W)
Location as "NE/CNWSW" or footage from lines C NE NW
Lease Owner C. E. G. Oil Company
Lease Name Dunkleburger Well No. 3
Office Address Howard, Kansas
Character of Well (completed as Oil, Gas or Dry Hole) Oil
Date well completed Unknown 19
Application for plugging filed 7-23 19 73
Application for plugging approved 7-23 19 73
Plugging commenced 8-22 19 73
Plugging completed 8-27 19 73
Reason for abandonment of well or producing formation Non profitable

If a producing well is abandoned, date of last production Unknown 19
Was permission obtained from the Conservation Division or its agents before plugging was commenced? Yes

Name of Conservation Agent who supervised plugging of this well Bert Wilcox
Producing formation _____ Depth to top _____ Bottom _____ Total Depth of Well 1323 Feet
Show depth and thickness of all water, oil and gas formations.

OIL, GAS OR WATER RECORDS

CASING RECORD

FORMATION	CONTENT	FROM	TO	SIZE	PUT IN	PULLED OUT
				7"	60'	None
				5"	1320'	60'

Describe in detail the manner in which the well was plugged, indicating where the mud fluid was placed and the method or methods used in introducing it into the hole. If cement or other plugs were used, state the character of same and depth placed, from _____ feet to _____ feet for each plug set.

Casing cemented in from bottom to approximately 60' of surface. Dumped 5 sx cement on bottom with baler. Bridged at 200' and ran 5 sx cement. Pulled 60' of 5" casing, bridged and ran 5 sx cement and soil to surface.


RECEIVED
STATE CORPORATION COMMISSION
AUG 30 1973
CONSERVATION DIVISION
Wichita, Kansas

(If additional description is necessary, use BACK of this sheet)
Name of Plugging Contractor: Lewis C. Long License # 28
Address: Hamilton, Kansas

STATE OF Kansas COUNTY OF Elk, ss.
Junior Smith (employee of owner) or (owner) of the above-described well, being first duly sworn on oath, says: That I have knowledge of the facts, statements, and matters herein contained and the log of the above-described well as filed and that the same are true and correct. So help me God.

(Signature) Junior Smith
Hamilton, Kansas (Address)

Subscribed and Sworn to before me this 27 day of August, 19 73

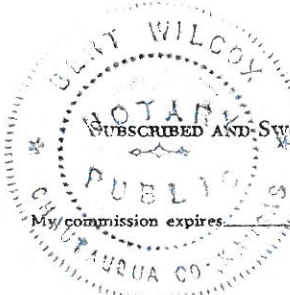

September 1, 1974

Notary Public.