


9-58

STATE Kansas	COMPANY Shawver-Arthur
COUNTY Butler	FARM Bolen
BLOCK 1	WELL NO. 1
SEC. 10	SURVEY
T. 29	R. 7E
TOTAL DEPTH 2945	
NE-NE-NE	
COMMENCED	
COMPLETED	
REMARKS DT Gen Good Samples	
ALTITUDE 1535	PRODUCTION D+A

CASING RECORD

SHOT	QUARTS	BETWEEN
------	--------	---------

FORM 186 - In stock and for sale by Ross-Martin Co., Tulsa

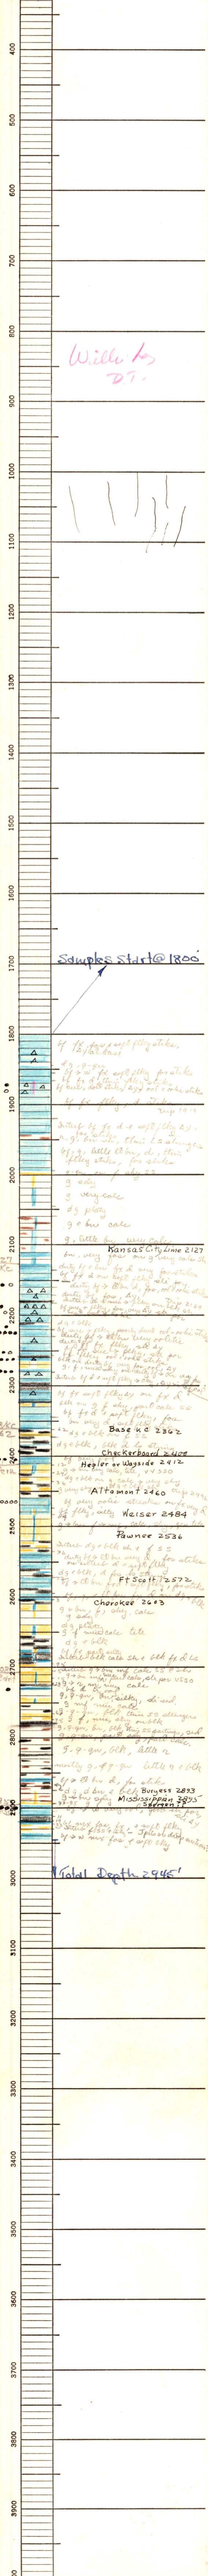

Total Depth 2945'