

HOT FILE

KANSAS

SEC. 30 TWP. Wilson R. 29 S 17 E

WELL NO.

3 Altoona

FARM

COMPANY

Sunray Mid-Continent (DEVELOPMENT)

CONTRACTOR

Mesker Drlg.
Altoona Field.

_____ FT. FROM N. LINE


990 _____ FT. FROM S. LINE

_____ FT. FROM E. LINE

330 _____ FT. FROM W. LINE

of SE/4

NW SW SE

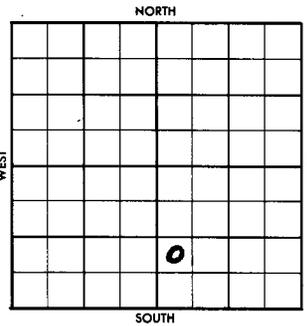

	ELEVATION	REPORT
1956		
10/3	1050'	Bartlesville Test <i>No FR</i> (DR#193)
10/4		MIRT Spudded 10-3-56 Drlg. 45'
10/5		Drlg. 550'
10/8		TD 924'. WOC - 5 1/2" @ 865'
10/9		TD 924'. WOC - 5 1/2" csg.
10/10		TD 924'. MICT
10/11		TD 924'. Cleaning out.
10/12		TD 924'. Prep to shoot 871-881'
10/15		TD 924'. Prep to test open hole 865-881'
10/16		TD 924'. Pumping open hole 865-881'
10/17		TD 924'. " " "
10/18		" " "
10/19		TD 924'. " " "
10/22		TD 924'. T.A. (DR#206)
ABANDONED		