


STATE OF KANSAS  
 STATE CORPORATION COMMISSION  
 Give All Information Completely  
 Make Required Affidavit  
 Mail or Deliver Report to:  
 Conservation Division  
 State Corporation Commission  
 212 North Market, Insurance Bldg.  
 Wichita, Kansas

WELL PLUGGING RECORD

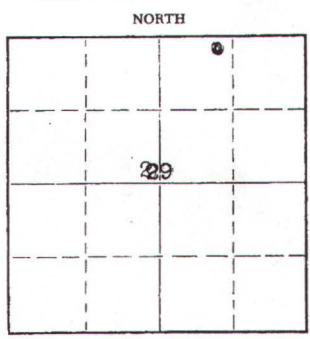

Locate well correctly on above Section Plat

Wilson County, Sec 29 Twp 29 Rge 17 (E) (W)  
 Location as "NE/CNW&SWK" or footage from lines N. 150 From E. 1620 NW NE NE  
 Lease Owner Carl C. Pickens  
 Lease Name Osborn Well No. 1.B  
 Office Address 1507 West 14th Hutchinson, Kansas  
 Character of Well (completed as Oil, Gas or Dry Hole)  
 Date well completed Oct 23, 1959  
 Application for plugging filed Oct 23, 19 59  
 Application for plugging approved Oct 28, 19 59  
 Plugging commenced 8 A.M. 19 59  
 Plugging completed 4 P.M. 19 59  
 Reason for abandonment of well or producing formation

If a producing well is abandoned, date of last production 19  
 Was permission obtained from the Conservation Division or its agents before plugging was commenced? Yes  
 Name of Conservation Agent who supervised plugging of this well Ora C. Reece Cherryvale, Kansas

Producing formation Depth to top Bottom Total Depth of Well Feet  
 Show depth and thickness of all water, oil and gas formations.

OIL, GAS OR WATER RECORDS				CASING RECORD		
FORMATION	CONTENT	FROM	TO	SIZE	PUT IN	PULLED OUT
Gravel	Water	16	18	10"	34"	34"
				8"	140	140
				6"	610	610

Describe in detail the manner in which the well was plugged, indicating where the mud fluid was placed and the method or methods used in introducing it into the hole. If cement or other plugs were used, state the character of same and depth placed, from 690 feet to back to 660 feet for each plug set, cement  
 Mud to 440 ~~back to 440~~ cement back to 410, mud from 410 to 140 cement from 140 to 110, mud from 110 to 30 then cement and soil to top.  
 All cement was put in with dump bailer.

RECEIVED  
 STATE CORPORATION COMMISSION  
 NOV 2 1959  
 CONSERVATION DIVISION  
 WICHITA, KANSAS

(If additional description is necessary, use BACK of this sheet)  
 Name of Plugging Contractor Lindsay Drilling Company  
 Address 1305 South Highland Chanute, Kansas

STATE OF Kansas, COUNTY OF Neosho, ss.  
 H. F. Lindsay (employee of owner) or (owner or operator) of the above-described well, being first duly sworn on oath, says: That I have knowledge of the facts, statements, and matters herein contained and the log of the above-described well as filed and that the same are true and correct. So help me God.  
 (Signature) H. F. Lindsay  
 (Address)

SUBSCRIBED AND SWORN to before me this 30th day of October, 19 59  
 Edna O. Weber  
 Edna O. Weber Notary Public.  
 My commission expires February 20, 1961