


WELL COMPLETION REPORT AND DRILLER'S LOG

API No. 15 — 133 — 22,291
 County Number

S. 1 T. 29S R. 18 E
 Loc. 330 SNL 100EWL NE4
 County McCasho

Operator Vera Cruz Petroleum
 Address 56312 Helena, Spokane, WA 99203
 Well No. FX-11 Lease Name Fowler
 Footage Location 330 feet from (N) line 110 feet from (W) line
 Principal Contractor H+M Oil Geologist _____
 Spud Date 2/12/81 Date Completed 11/15/81 Total Depth 750 P.B.T.D. _____
 Directional Deviation _____ Oil and/or Gas Purchaser Koch

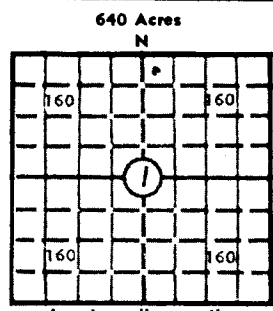

640 Acres
 N
 Elev.: Gr. _____
 DF _____ KB _____

CASING RECORD

Report of all strings set — surface, intermediate, production, etc.

Purpose of string	Size hole drilled	Size casing set (in O.D.)	Weight lbs/ft.	Setting depth	Type cement	Sacks	Type and percent additives
Surface	8"	6 5/8	17	60	Portland	12	
Casing	6"	2 3/8	6 1/2	750	"	95	

LINER RECORD

PERFORATION RECORD

Top, ft.	Bottom, ft.	Sacks cement	Shots per ft.	Size & type	Depth interval
			2	2 1/2 G-ISS	694-708

Size	Setting depth	Packer set at
1"	691	

ACID, FRACTURE, SHOT, CEMENT SQUEEZE RECORD

Amount and kind of material used	Depth interval treated
Water + Sand 8000 #	694-708

INITIAL PRODUCTION

Date of first production 12-15-81 Producing method (flowing, pumping, gas lift, etc.) _____
 RATE OF PRODUCTION PER 24 HOURS
 Oil 2.5 bbls. Gas — MCF Water 1 bbls. Gas-oil ratio — CFPB
 Disposition of gas (vented, used on lease or sold) _____ Producing interval (s) _____

INSTRUCTIONS: As provided in KCC Rule 82-2-125, within 90 days after completion of a well, one completed copy of this Drillers Log shall be transmitted to the State Geological Survey of Kansas, 4150 Monroe Street, Wichita, Kansas 67209. Copies of this form are available from the Conservation Division, State Corporation Commission, 245 No. Water, Wichita, Kansas 67202. Phone AC 316-522-2206. If confidential custody is desired, please note Rule 82-2-125. Drillers Logs will be on an open file in the Oil and Gas Division, State Geological Survey of Kansas, Lawrence, Kansas 66044.

Operator Vera Cruz Pet. DESIGNATE TYPE OF COMP.: OIL, GAS, DRY HOLE, SWDW, ETC.: Oil

Well No. FX-11 Lease Name Fowler

S 1 T 29S R 18 ^E/_W

WELL LOG
 Show all important zones of porosity and contents thereof; cored intervals, and all drill-stem tests, including depth interval tested, cushion used, time tool open, flowing and shut-in pressures, and recoveries. **SHOW GEOLOGICAL MARKERS, LOGS RUN, OR OTHER DESCRIPTIVE INFORMATION.**

FORMATION DESCRIPTION, CONTENTS, ETC.	TOP	BOTTOM	NAME	DEPTH
Shale + Limestone Oil Sand Shale	62	694		
	694	708		
	708	TD		

USE ADDITIONAL SHEETS, IF NECESSARY, TO COMPLETE WELL RECORD.

Date Received

B. Brown
 Signature
Sec. Man.
 Title
1-15-82
 Date