

KANSAS DRILLERS LOG


State Geological Survey
WICHITA, BRANCH

S. 3 T. 29 R. 22 E

Loc. S2 NE SE

County Crawford

640 Acres
N

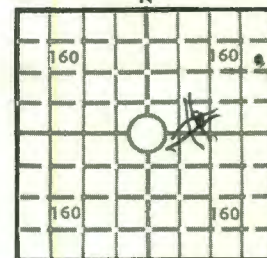

Locate well correctly

Elev.: Gr.

DF KB

API No. 15 — 037 — 20,149
County Number

Operator

Fred Giefer

Address

Route #2 Girard, Kansas

Well No.

#1

Lease Name

Fred Giefer

Footage Location

feet from (N) (S) line

feet from (E) (W) line

Principal Contractor

Geologist

Spud Date

Total Depth

P.B.T.D.

Date Completed

Oil Purchaser

CASING RECORD

Report of oil strings set — surface, intermediate, production, etc.

Purpose of string	Size hole drilled	Size casing set (in O.D.)	Weight lbs/ft.	Setting depth	Type cement	Sacks	Type and percent additives
Surface	10 in	8 5/8	26	25	Potted	4	none

LINER RECORD

Top, ft.	Bottom, ft.	Sacks cement
none		

PERFORATION RECORD

Shots per ft.	Size & type	Depth interval
none		

TUBING RECORD

Size	Setting depth	Packer set at
2 3/8	210	210

ACID, FRACTURE, SHOT, CEMENT SQUEEZE RECORD

Amount and kind of material used	Depth interval treated

INITIAL PRODUCTION

Date of first production 10-12-74	Producing method (flowing, pumping, gas lift, etc.) Flow
RATE OF PRODUCTION PER 24 HOURS	Oil
	Gas Sufficient Amount for production
	Water
	Gas-oil ratio
Disposition of gas (vented, used on lease or sold) Vented	Producing interval (s) Constant

INSTRUCTIONS: As provided in KCC Rule 82-2-125, within 90 days after completion of a well, one completed copy of this Drillers Log shall be transmitted to the State Geological Survey of Kansas, 4150 Monroe Street, Wichita, Kansas 67209. Copies of this form are available from the Conservation Division, State Corporation Commission, 3830 So. Meridian (P.O. Box 17027), Wichita, Kansas 66217. Phone AC 316-522-2206. If confidential custody is desired, please note Rule 82-2-125. Drillers Logs will be on open file in the Oil and Gas Division, State Geological Survey of Kansas, Lawrence, Kansas 66044.

Operator <i>Fred Giefer</i>		DESIGNATE TYPE OF COMP.: OIL, GAS, DRY HOLE, SWDW, ETC.:
Well No. <i>#1</i>	Lease Name <i>Fred Giefer</i>	
S ☐ T ☐ R ☐ E ☐ W ☐		


WELL LOG

Show all important zones of porosity and contents thereof; cored intervals, and all drill-stem tests, including depth interval tested, cushion used, time tool open, flowing and shut-in pressures, and recoveries.

SHOW GEOLOGICAL MARKERS, LOGS RUN,
OR OTHER DESCRIPTIVE INFORMATION.

FORMATION DESCRIPTION, CONTENTS, ETC.	TOP	BOTTOM	NAME	DEPTH
<i>Soil</i>	<i>0</i>	<i>2</i>		
<i>Clay</i>	<i>2</i>	<i>18</i>		
<i>Shale</i>	<i>18</i>	<i>75</i>		
<i>Lime</i>	<i>75</i>	<i>121</i>	<i>Fort Scott</i>	
<i>Shale</i>	<i>121</i>	<i>191</i>		
<i>Lime</i>	<i>191</i>	<i>211</i>	<i>osawego</i>	
<i>HANCOCK</i> <i>Shale</i>	<i>211</i>	<i>217</i>	<i>Gas</i>	
<i>Lime</i>	<i>217</i>	<i>225</i>		
<i>Shale</i>	<i>225</i>	<i>235</i>		
<i>Total D.</i>	<i>235</i>			
<i>Set packer</i>	<i>210</i>			

USE ADDITIONAL SHEETS, IF NECESSARY, TO COMPLETE WELL RECORD.

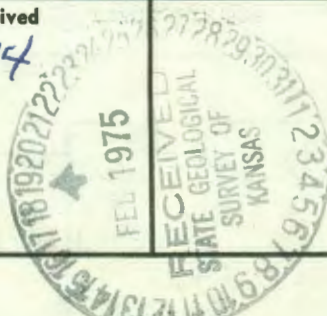Date Received <i>9-17-74</i>		<i>Fred Giefer</i> Signature <i>owner</i> Title <i>1-8-75</i> Date
---------------------------------	---	---