

KANSAS DRILLERS LOG

State Geological Survey
WICHITA, BRANCH

S. 17 T. 29 R. 22 E

Loc. NW SW NW

County Crawford

API No. 15 — 037 — 20,118
County Number

Operator
Donald & Thomas Call

Address
Route #1 Walnut, Kansas


Well No. #1 Lease Name
Donald & Thomas Call

Footage Location
1190 feet from (N) (S) line 160 feet from (E) (W) line

Principal Contractor Roy Fultz Geologist

Spud Date April 8, 1974 Total Depth 270 P.B.T.D.

Date Completed April 13, 1974 Oil Purchaser

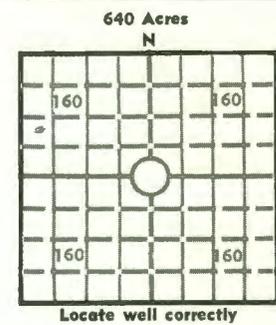

Elev.: Gr. _____
DF _____ KB _____

CASING RECORD

Report of all strings set — surface, intermediate, production, etc.

Purpose of string	Size hole drilled	Size casing set (in O.D.)	Weight lbs./ft.	Setting depth	Type cement	Sacks	Type and percent additives
Surface	6 1/4"	6"	20	25'	Portland	4	None

LINER RECORD

PERFORATION RECORD

Top, ft.	Bottom, ft.	Sacks cement	Shots per ft.	Size & type	Depth interval
None			None		

TUBING RECORD

Size	Setting depth	Packer set at
2 3/8"	240	240

ACID, FRACTURE, SHOT, CEMENT SQUEEZE RECORD

Amount and kind of material used	Depth interval treated

INITIAL PRODUCTION

Date of first production April 13, 1974	Producing method (flowing, pumping, gas lift, etc.) gas
RATE OF PRODUCTION PER 24 HOURS	Oil Gas Sufficient Water Gas-oil ratio
Disposition of gas (vented, used on lease or sold) Vented	Producing interval (s) Constant

INSTRUCTIONS: As provided in KCC Rule 82-2-125, within 90 days after completion of a well, one completed copy of this Drillers Log shall be transmitted to the State Geological Survey of Kansas, 4150 Monroe Street, Wichita, Kansas 67209. Copies of this form are available from the Conservation Division, State Corporation Commission, 3830 So. Meridian (P.O. Box 17027), Wichita, Kansas 66217. Phone AC 316-522-2206. If confidential custody is desired, please note Rule 82-2-125. Drillers Logs will be on open file in the Oil and Gas Division, State Geological Survey of Kansas, Lawrence, Kansas 66044.

Operator Donald & Thomas Call

DESIGNATE TYPE OF COMP.: OIL, GAS, DRY HOLE, SWDW, ETC.:

Well No.

Lease Name

#1

Donald & Thomas Call

S T R E W

WELL LOG

Show all important zones of porosity and contents thereof; cored intervals, and all drill-stem tests, including depth interval tested, cushion used, time tool open, flowing and shut-in pressures, and recoveries.

SHOW GEOLOGICAL MARKERS, LOGS RUN, OR OTHER DESCRIPTIVE INFORMATION.

FORMATION DESCRIPTION, CONTENTS, ETC.	TOP	BOTTOM	NAME	DEPTH
Soil 0	0	3		
Clay	3	6		
Lime	6	25		
Shale	25	117		
Lime (40 ft.)	117	147	Fort Scott	
Light Shale	147	223		
Lime (20 ft.)	223	243	Osawego	
Shale Dark	243	250	Gas	
Lime (5 ft.)	250	256		
Shale	256	262	Gas	
Sand	262	270	Gas	
Total Depth	270			
Packer Set	240'			

USE ADDITIONAL SHEETS, IF NECESSARY, TO COMPLETE WELL RECORD.

Date Received



Roy Fultz Driller

 Signature
Fultz Drilling Co.

 Title
 4-16-74

 Date

6960PC