

JUL

API 15 - 037 - 20575
State Geological Survey
WICHITA, BRANCH

KANSAS

WELL COMPLETION REPORT AND
DRILLER'S LOG

S. 18 T. 29 R. 22 ~~W~~

Loc. $\frac{1}{2}$ SE $\frac{1}{4}$ 550' fr. S. 660' fr

County Crawford

API No. 15 - 037 - 20575
County Number

Operator
Frank E. Oplotnik

Address
R.R. 4; Girard, Kans. 66743


Well No. 1 Lease Name Oplotnik

Footage Location
550 feet from (N) (S) line 660 feet from (E) (W) line

Principal Contractor V W & B Drilling Company Geologist

Spud Date 8-11-80 Date Completed 8-12-80 Total Depth 247 Feet P.B.T.D.

Directional Deviation Oil and/or Gas Purchaser

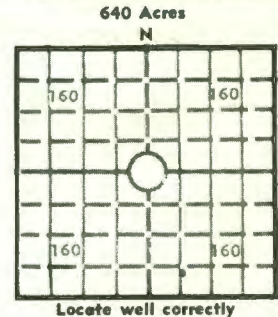

Elev.: Gr. _____

DF _____ KB _____

CASING RECORD

Report of all strings set— surface, intermediate, production, etc.

Purpose of string	Size hole drilled	Size casing set (in O.D.)	Weight lbs/ft.	Setting depth	Type cement	Sacks	Type and percent additives
Surface Casing	8-5/8"	5-1/2"	23 lbs.	30'	Portland	5	None

LINER RECORD

PERFORATION RECORD

Top, ft.	Bottom, ft.	Sacks cement	Shots per ft.	Size & type	Depth interval

TUBING RECORD

Size	Setting depth	Packer set at
1 inch	210 feet	210 feet

ACID, FRACTURE, SHOT, CEMENT SQUEEZE RECORD

Amount and kind of material used	Depth interval treated

INITIAL PRODUCTION

Date of first production		Producing method (flowing, pumping, gas lift, etc.)			
RATE OF PRODUCTION PER 24 HOURS	Oil	Gas	Water	Gas-oil ratio	
	bbis.	Not Known	MCF	bbis.	CFPB
Disposition of gas (vented, used on lease or sold)			Producing interval (s)		
Used on lease					

INSTRUCTIONS: As provided in KCC Rule 82-2-125, within 90 days after completion of a well, one completed copy of this Drillers Log shall be trans- mitted to the State Geological Survey of Kansas, 4150 Monroe Street, Wichita, Kansas 67209. Copies of this form are available from the Conservation Division, State Corporation Commission, 245 No. Water, Wichita, Kansas 67202. Phone AC 316-522-2206. If confidential custody is desired, please note Rule 82-2-125. Drillers Logs will be on open file in the Oil and Gas Division, State Geological Survey of Kansas, Lawrence, Kansas 66044.

Operator Frank E. Oplotnik		DESIGNATE TYPE OF COMP.: OIL, GAS, DRY HOLE, SWDW, ETC.:
Well No. 1	Lease Name Oplotnik	Gas Well
S 18 T 29 R 22 E XX		

WELL LOG

Show all important zones of porosity and contents thereof; cored intervals, and all drill-stem tests, including depth interval tested, cushion used, time tool open, flowing and shut-in pressures, and recoveries.

SHOW GEOLOGICAL MARKERS, LOGS RUN, OR OTHER DESCRIPTIVE INFORMATION.

FORMATION DESCRIPTION, CONTENTS, ETC.	TOP	BOTTOM	NAME	DEPTH
Top Soil	0	1		
Yellow Clay	1	7		
Sandstone	7	18		
Gray Shale	18	40		
Sandy Shale	40	55		
Gray Shale	55	105		
Lime	105	126		
Blk. Shale	126	128		
Lime	128	136		
Blk. Shale	136	139		
Dk. Shale	139	153		
Lt. Shale	153	159		
Sandy Shale	159	163		
Lt. Shale	163	177		
Gray Shale	177	204		
Lime	204	224		
Blk. Shale	224	231		
Lime	231	238		
Blk. Shale	238	243		
Lt. Shale	243	247		
Bottom of Hole		247		

USE ADDITIONAL SHEETS, IF NECESSARY, TO COMPLETE WELL RECORD.

Date Received	<p><i>William J. Billman</i> Signature</p> <p>General Partner of V W & B Drilling Company Title</p> <p><i>Aug 14-1980</i> Date</p>
---------------	--