

KANSAS DRILLERS LOG


State Geological Survey
WICHITA, BRANCHS. 31 T. 29 R. 22E ^E_W

Loc. E 1/2 SW

County Crawford

640 Acres

N

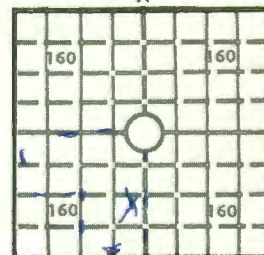

Locate well correctly

Elev.: Gr.

DF KB

API No. 15 — 037 — 20,189
County Number

Operator

Harrie L. Collier

Address

Route #1, McCune, Kansas

Well No.
#1

Lease Name

Harrie L. Collier

Footage Location

1000 feet from (N) (S) line

165 feet from (E) (W) line

Principal Contractor

Furtz Drilling

Geologist

Spud Date

5-12-75

Total Depth

160

P.B.T.D.

Date Completed

5-21-75

Oil Purchaser

CASING RECORD

Report of all strings set—surface, intermediate, production, etc.

Purpose of string	Size hole drilled	Size casing set (in O.D.)	Weight lbs/ft.	Setting depth	Type cement	Sacks	Type and percent additives
Surface	10"	8 5/8	24	25	Portland	4	none

LINER RECORD

PERFORATION RECORD

Top, ft.	Bottom, ft.	Sacks cement	Shots per ft.	Size & type	Depth interval

TUBING RECORD

Size	Setting depth	Packer set at
2 3/8	134	134

ACID, FRACTURE, SHOT, CEMENT SQUEEZE RECORD

Amount and kind of material used	Depth interval treated

INITIAL PRODUCTION

Date of first production 5-21-75		Producing method (flowing, pumping, gas lift, etc.)			
RATE OF PRODUCTION PER 24 HOURS		Oil	Gas Gas	Water	Gas-oil ratio
		bbls.	MCF	bbls.	CFPB
Disposition of gas (vented, used on lease or sold) Vented			Producing interval(s) Constant		

INSTRUCTIONS: As provided in KCC Rule 82-2-125, within 90 days after completion of a well, one completed copy of this Drillers Log shall be transmitted to the State Geological Survey of Kansas, 4150 Monroe Street, Wichita, Kansas 67209. Copies of this form are available from the Conservation Division, State Corporation Commission, 3830 So. Meridian (P.O. Box 17027), Wichita, Kansas 66217. Phone AC 316-522-2206. If confidential custody is desired, please note Rule 82-2-125. Drillers Logs will be on open file in the Oil and Gas Division, State Geological Survey of Kansas, Lawrence, Kansas 66044.

Operator

DESIGNATE TYPE OF COMP.: OIL, GAS,
DRY HOLE, SWDW, ETC.:

Well No.

Lease Name

S 31 T 29 R 22 E

WELL LOG

Show all important zones of porosity and contents thereof; cored intervals, and all drill-stem tests, including depth interval tested, cushion used, time tool open, flowing and shut-in pressures, and recoveries.

SHOW GEOLOGICAL MARKERS, LOGS RUN,
OR OTHER DESCRIPTIVE INFORMATION.

FORMATION DESCRIPTION, CONTENTS, ETC.

TOP

BOTTOM

NAME

DEPTH

SOIL

0

2

CLAY

2

15

SHALE

15

19

LIME

19

47 Ft. Scott

SHALE

47

115

Lime

115

134 Oswego

SHALE

134

140 Gas

Lime

140

150


SHALE

150

161 Gas

L.D. 161'

Set Packer 134'

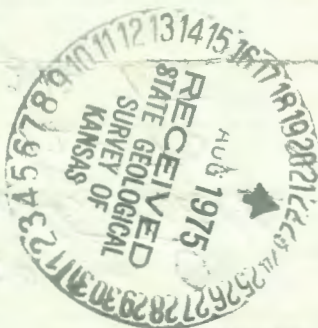

USE ADDITIONAL SHEETS, IF NECESSARY, TO COMPLETE WELL RECORD.

Date Received

Signature

Title

Date

Harrie L. Collier
owner
May 28 - 1975
Mcune Kan. R. 1 66753

266592