

15-051-20308

State Geological Survey
WICHITA BRANCH
KANSAS DRILLERS LOG

S. 18 T. 29 R. 22 E
Loc. SW SW
County Crawford

API No. 15 — 037 — 20,358
County Number

Operator
Stefanie Oplotnik

Address
Route #4, Box #189 Girard, Kansas 66743


Well No. #2 Lease Name Mrs. Stephanie Oplotnik

Footage Location
500 feet from (N) (S) line 600 feet from (E) (W) line

Principal Contractor Furtak Drilling Co. Geologist

Spud Date Feb 06-79 Total Depth 250 P.B.T.D.

Date Completed 2-26-79 Oil Purchaser

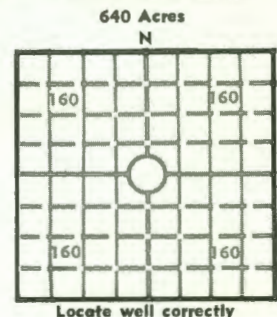

Elev.: Gr. _____
DF _____ KB _____

CASING RECORD

Report of oil strings set — surface, intermediate, production, etc.

Purpose of string	Size hole drilled	Size casing set (in O.D.)	Weight lbs/ft.	Setting depth	Type cement	Sacks	Type and percent additives
Surface	8	6 1/4	17	26	monarch	5	

LINER RECORD

PERFORATION RECORD

Top, ft.	Bottom, ft.	Sacks cement	Shots per ft.	Size & type	Depth interval

TUBING RECORD

Size	Setting depth	Packer set at

ACID, FRACTURE, SHOT, CEMENT SQUEEZE RECORD

Amount and kind of material used	Depth interval treated
Dry Hole	
saved for water well	

INITIAL PRODUCTION

Date of first production		Producing method (flowing, pumping, gas lift, etc.)			
RATE OF PRODUCTION PER 24 HOURS	Oil bbls.	Gas MCF	Water bbls.	Gas-oil ratio CFPB	
Disposition of gas (vented, used on lease or sold)			Producing interval(s)		

INSTRUCTIONS: As provided in KCC Rule 82-2-125, within 90 days after completion of a well, one completed copy of this Drillers Log shall be transmitted to the State Geological Survey of Kansas, 4150 Monroe Street, Wichita, Kansas 67209. Copies of this form are available from the Conservation Division, State Corporation Commission, 3830 So. Meridian (P.O. Box 17027), Wichita, Kansas 66217. Phone AC 316-522-2206. If confidential custody is desired, please note Rule 82-2-125. Drillers Logs will be on open file in the Oil and Gas Division, State Geological Survey of Kansas, Lawrence, Kansas 66044.

Operator Stefanie Oplotnik DESIGNATE TYPE OF COMP.: OIL, GAS, DRY HOLE, SWDW, ETC.:

Well No. _____ Lease Name Stefanie Oplotnik Dry Hole

S 18 T 29 R 22 ^E _W Saved for water well

WELL LOG

Show all important zones of porosity and contents thereof; cored intervals, and all drill-stem tests, including depth interval tested, cushion used, time tool open, flowing and shut-in pressures, and recoveries.

SHOW GEOLOGICAL MARKERS, LOGS RUN, OR OTHER DESCRIPTIVE INFORMATION.

FORMATION DESCRIPTION, CONTENTS, ETC.	TOP	BOTTOM	NAME	DEPTH
Soil	0	2		
Shale	2	12		
Sand Rock	12	25		
Shale	25	106		
Lime	106	138	Fort Scott	
Shale	138	206		
Lime	206	226	oswego	
Shale	226	234		
Lime	234	240		
Shale	240	250		
T.D.	250			

USE ADDITIONAL SHEETS, IF NECESSARY, TO COMPLETE WELL RECORD.

Date Received <u>2-8-79</u>	<u>Stefanie Oplotnik</u> Signature
	<u>owner</u> Title
	<u>March 12-79</u> Date