


X

S. 31 T. 29 R. 22 E

Loc. N2 SE  
County Crawford

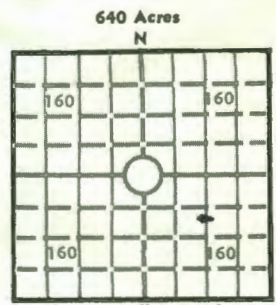

Locate well correctly

Elev.: Gr. \_\_\_\_\_

DF \_\_\_\_\_ KB \_\_\_\_\_

**KANSAS DRILLERS LOG**

API No. 15 — 037 — 20,116  
County Number

Operator  
Charles Shanholtzer

Address R. R. #1 McCune, Kansas

Well No. #1 Lease Name Charles Shanholtzer

Footage Location 200 S. Line 80 rods west  
feet from (N) (S) line feet from (E) (W) line

Principal Contractor Roy Fultz Geologist \_\_\_\_\_

Spud Date 2-26-74 Total Depth 165 P.B.T.D. \_\_\_\_\_

Date Completed 3-4-74 Oil Purchaser \_\_\_\_\_

**CASING RECORD**

Report of all strings set — surface, intermediate, production, etc.

Purpose of string	Size hole drilled	Size casing set (in O.D.)	Weight lbs./ft.	Setting depth	Type cement	Sacks	Type and percent additives
Surface	6 1/4	6	20	40	Portland	4	none

**LINER RECORD**

**PERFORATION RECORD**

Top, ft.	Bottom, ft.	Sacks cement	Shots per ft.	Size & type	Depth interval
none			none		

**TUBING RECORD**

Size	Setting depth	Packer set at
2 3/8	139	139

**ACID, FRACTURE, SHOT, CEMENT SQUEEZE RECORD**

Amount and kind of material used	Depth interval treated

**INITIAL PRODUCTION**

Date of first production <u>3-4-74</u>		Producing method (flowing, pumping, gas lift, etc.) <u>gas</u>		
RATE OF PRODUCTION PER 24 HOURS	Oil	Gas sufficient	Water	Gas-oil ratio
		for home		
Disposition of gas (vented, used on lease or sold)		bbis.	MCF	bbis. CFPB
<u>vented</u>				
Producing interval(s)	<u>constant</u>			

**INSTRUCTIONS:** As provided in KCC Rule 82-2-125, within 90 days after completion of a well, one completed copy of this Drillers Log shall be transmitted to the State Geological Survey of Kansas, 4150 Monroe Street, Wichita, Kansas 67209. Copies of this form are available from the Conservation Division, State Corporation Commission, 3830 So. Meridian (P.O. Box 17027), Wichita, Kansas 66217. Phone AC 316-522-2206. If confidential custody is desired, please note Rule 82-2-125. Drillers Logs will be on open file in the Oil and Gas Division, State Geological Survey of Kansas, Lawrence, Kansas 66044.

Operator

Charles Shanholtzer

DESIGNATE TYPE OF COMP.: OIL, GAS, DRY HOLE, SWDW, ETC.:

Well No.

;

Lease Name

Charles Shanholtzer

S \_\_\_\_\_ T \_\_\_\_\_ R \_\_\_\_\_ E \_\_\_\_\_ W

### WELL LOG

Show all important zones of porosity and contents thereof; cored intervals, and all drill-stem tests, including depth interval tested, cushion used, time tool open, flowing and shut-in pressures, and recoveries.

SHOW GEOLOGICAL MARKERS, LOGS RUN, OR OTHER DESCRIPTIVE INFORMATION.

FORMATION DESCRIPTION, CONTENTS, ETC.	TOP	BOTTOM	NAME	DEPTH
Soil	0	2		
Clay	2	25		
Lime	25	54		
Dark Shale	54	75		
Light Shale	75	115		
Dark Shale	115	122		
Lime	122	141		
Dark Shale	141	147		
Lime	147	157		
Shale	157	165		
Gas	165			

USE ADDITIONAL SHEETS, IF NECESSARY, TO COMPLETE WELL RECORD.

Date Received



Signature

Title

Date