

State of Kansas



JOHN CARLIN
R. C. LOUX
JANE T. ROY
PHILLIP R. DICK
CAROL J. LARSON

Governor
Chairman
Commissioner
Commissioner
Executive Secretary

State Corporation Commission

CONSERVATION DIVISION

(Oil, Gas and Water)
245 North Water
WICHITA, KANSAS 67202

September 10, 1980

WELL PLUGGING AUTHORITY

Well No.	2
Lease	Oplotink
Description	NW NW SE
Section	18-29S-22E
County	Crawford
Total Depth	462'
Plugging Contractor	V W & B

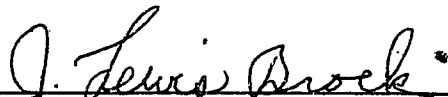
Frank E. Oplotink
Rt. 4
Girard, Ks 66743

Gentlemen:

This is your authority to plug the above subject well in accordance with the Rules and Regulations of the State Corporation Commission.

This authority is void after ninety (90) day from the above date.

Yours very truly,

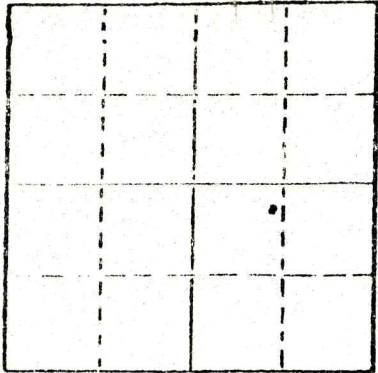

J. LEWIS BROCK, Administrator

Andy Reed Box 56 Thayer, Ks 66776
is hereby assigned to supervise the plugging of the above named well

STATE OF KANSAS
STATE CORPORATION COMMISSION

WELL PLUGGING RECORD

Give All Information Completely
Make Required Affidavit
Mail or Deliver Report to
Conservation Division
State Corporation Comm.
245 North Water
Wichita, KS 67202



Locate well correctly on above
Section Plat

Crawford County. Sec. 18 Twp. 29 Rge. 22 E/W
Location as "NE/CNW1SW1" or footage from lines W1SE1 560'
from West Line, 240' from North Line.
Lease Owner Frank E. Oplotnik
Lease Name Frank E. Oplotnik Well No. 2
Office Address R.R.4; Girard, Kans. 66743
Character of Well (Completed as Oil, Gas or Dry Hole) X
Dry Hole-
Date Well completed 8-29-1980
Application for plugging filed 8-29-80 19
Application for plugging approved 8-29-80 19
Plugging commenced 8-29-80 19
Plugging completed 8-29-80 19
Reason for abandonment of well or producing formation

Dry Hole
If a producing well is abandoned, date of last production 19

Was permission obtained from the Conservation Division or
its agents before plugging was commenced? Yes

Name of Conservation Agent who supervised plugging of this well Andrew Reed
Producing formation Depth to top Bottom Total Depth of Well
Show depth and thickness of all water, oil and gas formations.

OIL, GAS OR WATER RECORDS

CASING RECORD

FORMATION	CONTENT	FROM	TO	SIZE	PUT IN	PULLED OUT

Describe in detail the manner in which the well was plugged, indicating where the mud fluid
was placed and the method or methods used in introducing it into the hold. If cement or other
plugs were used, state the character of same and depth placed, from feet to
feet for each plug set.

1st plug set 250' 10 sacks of portland cement put on top of plug, with baler
2nd plug set 60' 6 sacks of portland cement put on top of plug, by dump.
3rd plug set 5' 2 sacks of portland cement put on top of plug by dump.

(If additional description is necessary, use BACK of this sheet)

Name of Plugging Contractor William J. Billman - V W & B Drilling Company

STATE OF Kansas COUNTY OF Labette, ss.
William J. Billman General Partner V W B Drilling (employee of owner) or (owner or operator)
of the above-described well, being first duly sworn on oath, says: That I have knowledge of
the facts, statements, and matters herein contained and the log of the above-described well
as filed and that the same are true and correct. So help me God.

(Signature) William J. Billman
Box 7; N. Highway; Cherryvale, Kans. 67335
(Address)

SUBSCRIBED AND SWORN TO before me this 2nd day of September, 1980

MARGARET C. HOOBLER
STATE NOTARY PUBLIC
Labette County, Kansas
My Appointment Expires:
May 14, 1984

Margaret C. Hoobler
Notary Public.

My commission expires