


KANSAS DRILLERS LOG State Geological Survey
WICHITA, BRANCH

S. 6 T. 29 R. 23 ^E/_W

Loc. S2 E2 SW

County Crawford

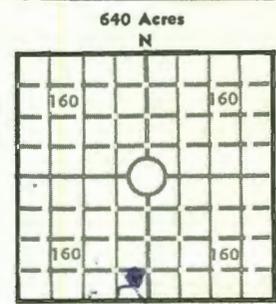

Locate well correctly

Elev.: Gr. _____

DF _____ KB _____

API No. 15 — 037 — 20,134
County Number

Operator
Verdan J. LaForge

Address R. #2 Girard, Kansas

Well No. #1 Lease Name Verdan J. LaForge

Footage Location
165 feet from XX (S) line 1620 feet from (E) XX line

Principal Contractor _____ Geologist _____

Spud Date September 5, 1974 Total Depth _____ P.B.T.D. _____

Date Completed September 12, 1974 Oil Purchaser _____

CASING RECORD

Report of all strings set — surface, intermediate, production, etc.

Purpose of string	Size hole drilled	Size casing set (in O.D.)	Weight lbs/ft.	Setting depth	Type cement	Sacks	Type and percent additives
Surface	8	8	20	25	Portland	4	none

LINER RECORD

PERFORATION RECORD

Top, ft.	Bottom, ft.	Sacks cement	Shots per ft.	Size & type	Depth interval
none			none	none	none

TUBING RECORD

Size	Setting depth	Packer set at
2 3/8	110	110

ACID, FRACTURE, SHOT, CEMENT SQUEEZE RECORD

Amount and kind of material used	Depth interval treated

INITIAL PRODUCTION

Date of first production September 12, 1974 Producing method (flowing, pumping, gas lift, etc.) _____

RATE OF PRODUCTION PER 24 HOURS	Oil	Gas	Water	Gas-oil ratio
	bbis.	Gas MCF		bbis. CFPB

Disposition of gas (vented, used on lease or sold) Vented sufficient amount for home Producing interval(s) constant

INSTRUCTIONS: As provided in KCC Rule 82-2-125, within 90 days after completion of a well, one completed copy of this Drillers Log shall be transmitted to the State Geological Survey of Kansas, 4150 Monroe Street, Wichita, Kansas 67209. Copies of this form are available from the Conservation Division, State Corporation Commission, 3830 So. Meridian (P.O. Box 17027), Wichita, Kansas 66217. Phone AC 316-522-2206. If confidential custody is desired, please note Rule 82-2-125. Drillers Logs will be on open file in the Oil and Gas Division, State Geological Survey of Kansas, Lawrence, Kansas 66044.

Operator

DESIGNATE TYPE OF COMP.: OIL, GAS, DRY HOLE, SWDW, ETC.:

Well No.

#1

Lease Name

Verdan J. LaForge

S T R W

WELL LOG

Show all important zones of porosity and contents thereof; cored intervals, and all drill-stem tests, including depth interval tested, cushion used, time tool open, flowing and shut-in pressures, and recoveries.

SHOW GEOLOGICAL MARKERS, LOGS RUN, OR OTHER DESCRIPTIVE INFORMATION.

FORMATION DESCRIPTION, CONTENTS, ETC.	TOP	BOTTOM	NAME	DEPTH
Soil	0	8		
Line	8	32		
Shale	32	95		
Line	95	110		
Shale	110	115		
Line	115	124		
Shale	124	135		
Total Depth		135		
Set Packer 110 feet				

USE ADDITIONAL SHEETS, IF NECESSARY, TO COMPLETE WELL RECORD.

Date Received



Verdan J. LaForge
Signature

Title

Date