

**State Geological Survey
WICHITA, BRANCH**

KANSAS DRILLERS LOG

S. 35 T. 29 R. 24 E

Loc. SW

County Crawford

API No. 15 — 037 — 20,114
County Number

Operator
Tony Bracket

Address Radley, Kansas


Well No. #1 Lease Name Tony Bracket

Footage Location 185' S. Line 40 rods from West
feet from (N) (S) line feet from (E) (W) line

Principal Contractor Roy Fultz Geologist

Spud Date 12-22-73 Total Depth 360 P.B.T.D.

Date Completed 2-9-74 Oil Purchaser

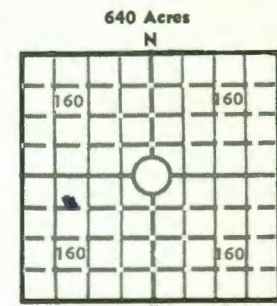

Locate well correctly
Elev.: Gr. _____

DF _____ KB _____

CASING RECORD

Report of all strings set — surface, intermediate, production, etc.

Purpose of string	Size hole drilled	Size casing set (in O.D.)	Weight lbs/ft.	Setting depth	Type cement	Sacks	Type and percent additives
Surface	6 1/4	6"	20	40'	Portland	4	none

LINER RECORD

PERFORATION RECORD

Top, ft.	Bottom, ft.	Sacks cement	Shots per ft.	Size & type	Depth interval
none			none		

TUBING RECORD

Size	Setting depth	Packer set at
2 3/8	350	350

ACID, FRACTURE, SHOT, CEMENT SQUEEZE RECORD

Amount and kind of material used	Depth interval treated

INITIAL PRODUCTION

Date of first production <u>2-9-74</u>	Producing method (flowing, pumping, gas lift, etc.) <u>gas</u>			
RATE OF PRODUCTION PER 24 HOURS	Oil	Gas <u>sufficient for home</u>	Water	Gas-oil ratio
Disposition of gas (vented, used on lease or sold) <u>vented</u>	bbis.	MCF	bbis.	CFPB
Producing interval (s) <u>constant</u>				

INSTRUCTIONS: As provided in KCC Rule 82-2-125, within 90 days after completion of a well, one completed copy of this Drillers Log shall be transmitted to the State Geological Survey of Kansas, 4150 Monroe Street, Wichita, Kansas 67209. Copies of this form are available from the Conservation Division, State Corporation Commission, 3830 So. Meridian (P.O. Box 17027), Wichita, Kansas 66217. Phone AC 316-522-2206. If confidential custody is desired, please note Rule 82-2-125. Drillers Logs will be on open file in the Oil and Gas Division, State Geological Survey of Kansas, Lawrence, Kansas 66044.

Operator **Tony Brackett** DESIGNATE TYPE OF COMP.: OIL, GAS, DRY HOLE, SWDW, ETC.:

Well No. **1** Lease Name **Tony Brackett**

S T R E W


WELL LOG

Show all important zones of porosity and contents thereof; cored intervals, and all drill-stem tests, including depth interval tested, cushion used, time tool open, flowing and shut-in pressures, and recoveries.

SHOW GEOLOGICAL MARKERS, LOGS RUN, OR OTHER DESCRIPTIVE INFORMATION.

FORMATION DESCRIPTION, CONTENTS, ETC.	TOP	BOTTOM	NAME	DEPTH
Clay	0	38		
Lime	38	42		
Shale	42	269		
Sand	269			
Gas	292	played out		
Sand	292	300		
Shale	300	350		
Sand	350	352		
Sand Gas	352	355		
Chat	355	360		
Total Depth 360				

USE ADDITIONAL SHEETS, IF NECESSARY, TO COMPLETE WELL RECORD.

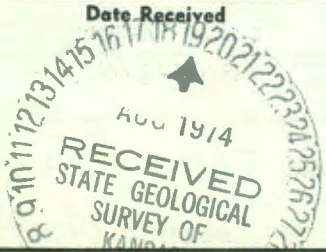Date Received

 RECEIVED
 STATE GEOLOGICAL
 SURVEY OF
 KANSAS

 Signature

 Title

 Date