LAUGHLIN-SIMMONS & CO. OF KANSAS, INC.
OILWELL ELEVATIONS AND LOCATIONS
2121 W. 18TH STREET (316) 943-5351
WICHITA, KANSAS 67203

7-16-75
DATE

Butler — COUNTY
35 29s 6e — S T R
CS/2 NW NE — LOCATION


Crowe Drlg — OPERATOR
X 1 — NO.
Blair C - — FARM

ELEVATION: 1445 Gr

Crowe Drilling Company
1732 Kansas State Bank Building
Wichita, Kansas 67202

SCALE: 2" = 1 Mile

5' iron rod
1' wood stake & flagging
Level pasture (cattle)

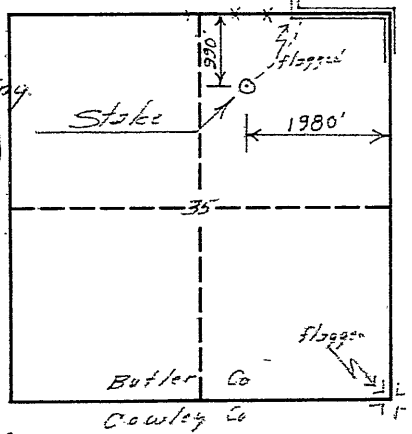

MINIMUM STAKING CHARGE: $65.00
(INCLUDES GROUND ELEVATION)
EXTRA TIME & MILEAGE: _____
ELEVATION CHARGE: _____
TOTAL: $65.00

Thank you,
R. E. Moser
L-S SURVEYOR

Laughlin-Simmons & Co. of Kansas, Inc. is not liable in case of errors and/or ommissions.