

**F.W. MORGAN**  
**GEOLOGIST**

305 S. WASHINGTON  
ELDORADO, KANSAS 67042

August 12, 1985

(316) 263-0134  
ELDORADO (316) 321-1463

Razook Oil Company  
R. R. # 4, Box 102  
Augusta, Kansas, 67010

Re: Your No. 1 House "B"  
Sec. 9-29S-4E  
Butler County, Ks

Gentlemen:

Enclosed is my geological log on the above listed well. Plotted on the log is lithology, formation top, drilling rate, and shows of oil and gas where noted in samples, etc.

This was a Lansing test, and shows of oil were found as follows:

1815 - 1817 - This zone had a slight show of free oil and no odor.  
Experience in the area leads us to believe is water.

1821 -- 1835 - This zone had a good show of oil, odor, some gas, and staining in a fossiliferous with good vugular porosity.  
This is the producing zone in the Asmussen Pool.

I recommend that you perforate from 1821 to 1823 or 1824 subject to log correlation. Casing was run and cemented at 1879; to test this zone.

Sincerely,

  
F. W. Morgan





LAUGHLIN-SIMMONS & CO. OF KANSAS, INC.

OIL FIELD SURVEYING  
1337 NORTH MERIDIAN, SUITE 2  
WICHITA, KANSAS 67203

(316) 943-5351

KW7268511  
INVOICE NO.

RAZOOK OIL COMPANY  
OPERATOR

1-B  
NO.

House  
FARM

Butler  
COUNTY

9 29s 4e  
S T R


C S/2 S/2 SW  
LOCATION

ELEVATION: 1195 gr



RAZOOK OIL COMPANY  
R. R. 4 Box 102  
Augusta, Kansas 67010

AUTHORIZED BY: Frank Morgan

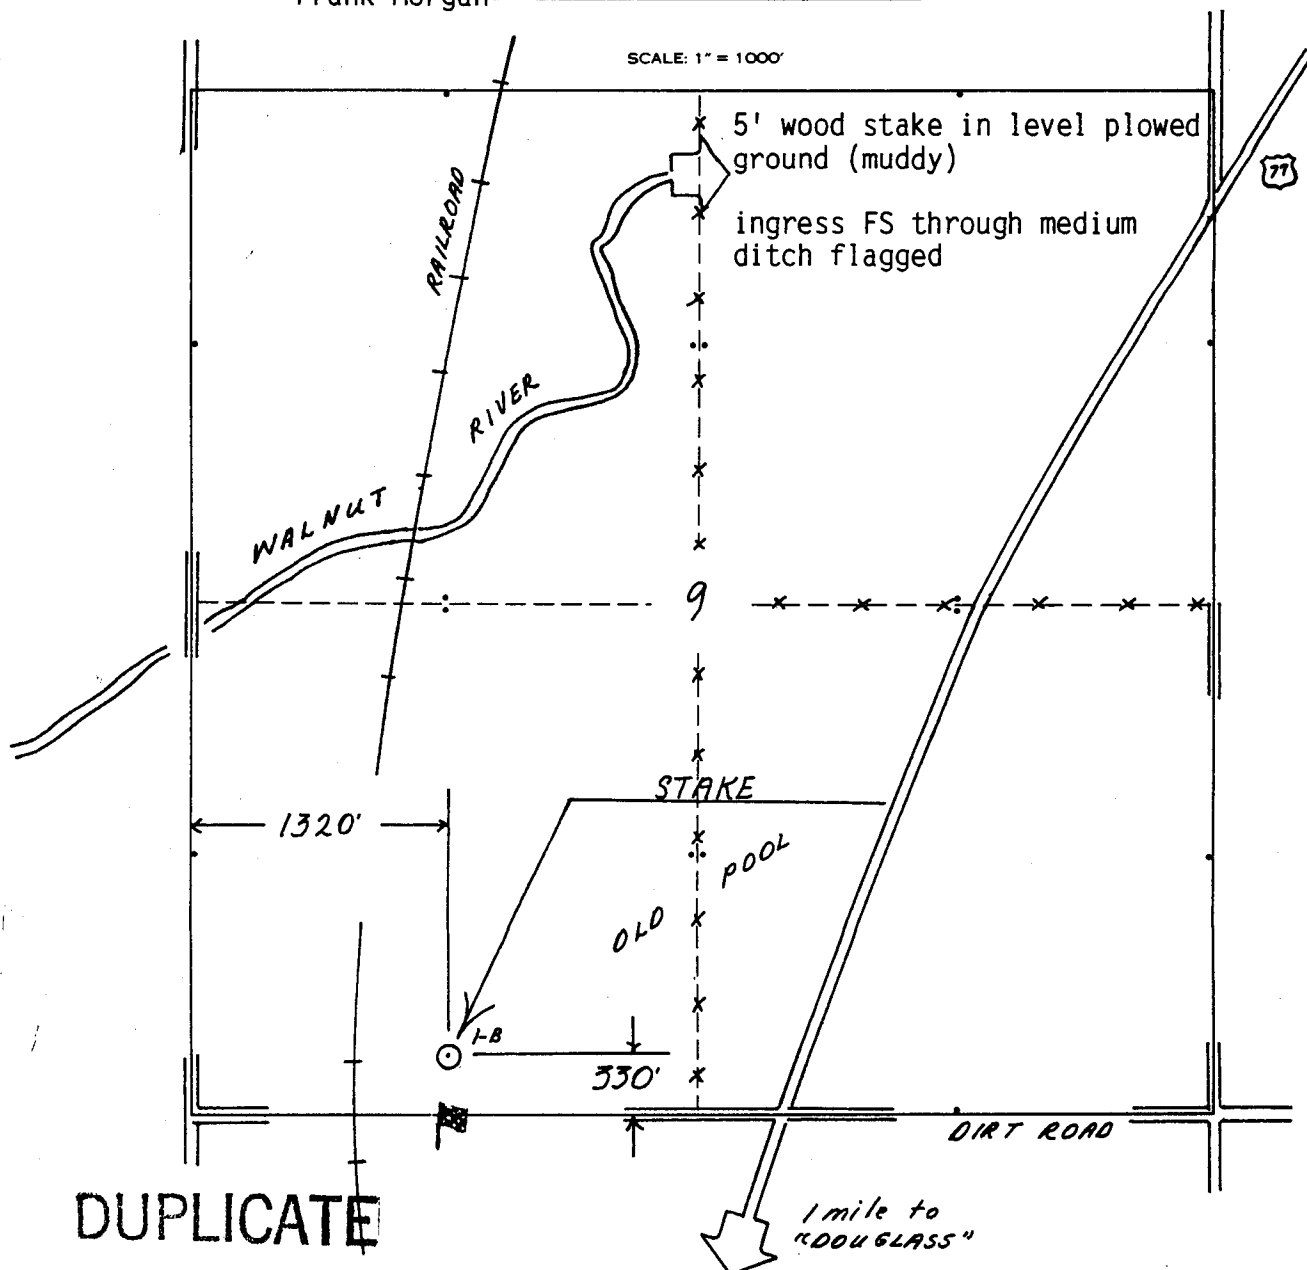

DUPLICATE