


Map No. **KANSAS** Sec. **16** Twp. **2^S** R. **1^E**

Well No. **1 - Sanfield** Farm

Mitchell O & G Company

NORTH

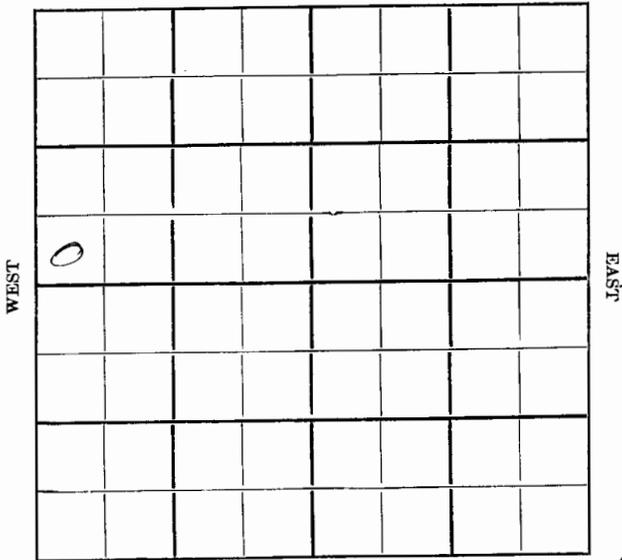

SOUTH


5

Map No. Sec. Twp. R.

Well No. Farm

Company

NORTH

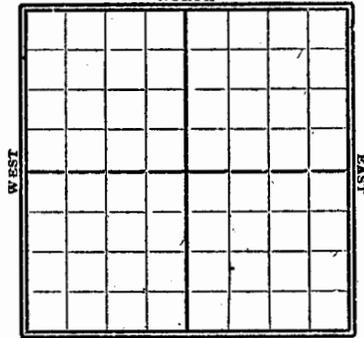

SOUTH

..... Ft. from N. Line

..... Ft. from S. Line

..... Ft. from E. Line

..... Ft. from W. Line

1923

Date

REPORT

Gypay Records

8/8 sand + lime { 3190'
 { 4100'

HFW

Abd TD 4100'

Location.....
Drilling Remarks

Rig Up.....
Drilling Remarks

RECORD

PRODUCTION

Cased..... in..... ft.
Sand.....
Gas.....
Oil.....
Total Depth.....

1st 24 hrs. Nat.....
1st 24 hrs. after shot.....
Gas..... cu. ft.....
Dry Hole.....
Abandoned.....

25

MAP NO. _____ SEC. 16 TWP. 25 R. 1E

WELL NO. #1 Canfield
Mitchell & S. Co. COMPANY

CONTRACTOR _____

no wall
map

SECTION PLAT

_____ FT. FROM N. LINE

_____ FT. FROM S. LINE

_____ FT. FROM E. LINE

_____ FT. FROM W. LINE

RECORD

LOCATION _____

CASED _____ IN. _____ FT.

RIG UP _____

SAND _____

DRILLING AND REMARKS:

GAS _____

OIL _____

TOTAL DEPTH 4100

3190 } sand
4100 } line
H. S. A.

PRODUCTION

1ST 24 HRS. NAT. _____

1ST 24 HRS. AFTER SHOT _____

GAS _____ CU. FT.

DRY HOLE

ABANDONED

DATE 5/8 1923

SCOUT