

KANSAS

Section 16 Township _____ Range 13E

Sec. 16 Twp. 2 R. 13E


Well No. 1 Murdock

Well No. #1 Murdock Farm _____

Company Texas

Texas Company

Wildcat

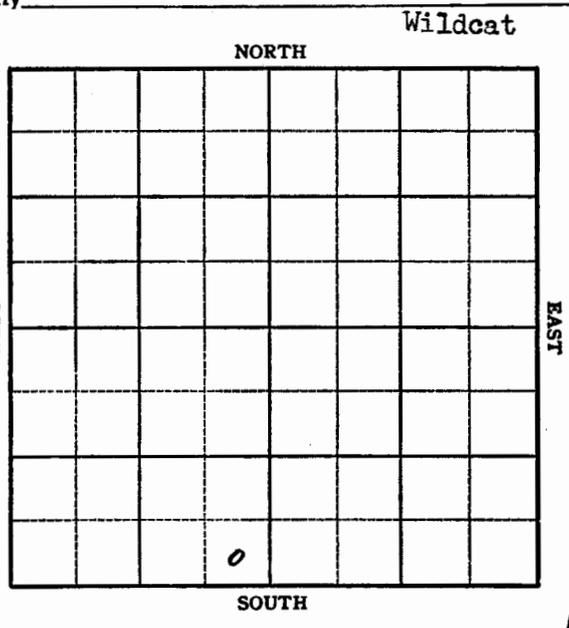


_____ Ft. from N. Line

330' Ft. from S. Line

330' Ft. from E. Line

_____ Ft. from W. Line

SE SW

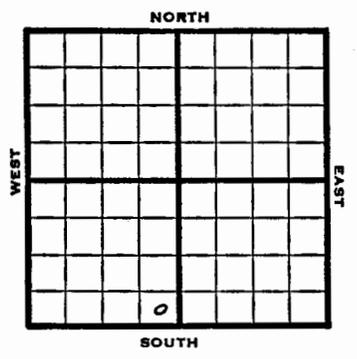

1949	REPORT
9/7	Location
9/14	"
9/21	Drig. 195'
9/28	TD 846'
	Heeb 432
	Lans. 538'
	Sand 790'
	Granite 838'
	Aband.
	ABANDONED

14

no elev

Map No. _____ Sec. 16 Twp. 2 R. 13E


Well No. 1 Murdock

Texas _____ Company

Contractor

SE SW

FIRST REPORT
SECTION PLAT

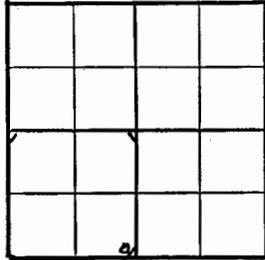

_____ Ft. from N. Line

330 Ft. from S. Line

330 Ft. from E. Line

_____ Ft. from W. Line

Nemaha County

Location _____

Rig up _____

Drilling and Remarks:

RECORD

Cased _____ in., _____ ft.

Sand _____

Gas _____

Oil _____

Total Depth _____

PRODUCTION

1st 24 hrs. Nat. _____

1st 24 hrs. after shot _____

Gas _____ Cu. Ft.

Dry Hole _____

Abandoned _____

Date

SEP 7 1949 19

S. J. LEWIS

Scout

~~Kansas~~

Map No. _____ Sec. 16 Twp. 2 R. 13E

Well No. 1 Murdock


Texas _____ Company

Contractor

ABANDONED

SE SW

SECTION PLAT

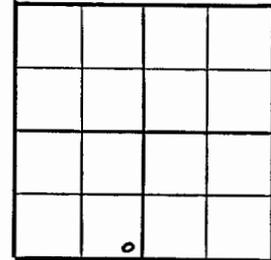

_____ Ft. from N. Line

330 Ft. from S. Line

330 Ft. from E. Line

_____ Ft. from W. Line

Nemaha County

Location _____

Rig up _____

Drilling and Remarks:

Acc 432

Line 388

Sand 790

Granite 737

RECORD

Cased _____ in., _____ ft.

Sand _____

Gas _____

Oil _____

Total Depth 846

PRODUCTION

1st 24 hrs. Nat. _____

1st 24 hrs. after shot _____

Gas _____ Cu. Ft.

Dry Hole _____

Abandoned _____

Date

SEP 28 1949 19

S. J. LEWIS

Scout