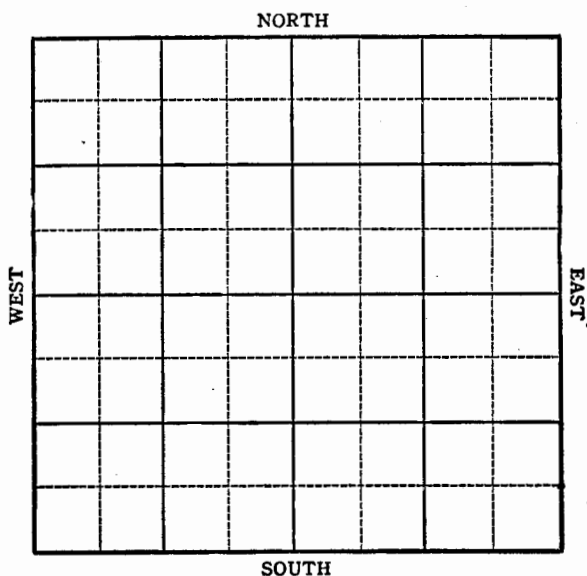


15131000180000

FORM 51 5M BR1X

KANSAS Nemaha County

Section 3 Township 2 Range 14EWell No. #1 LamparterCompany Fred CulpepperFORM 252-A
5M 9-44 PETROL

KANSAS

Nemaha County

Sec. 3 Twp. 2 R. 14EWell No. #1 Lamparter FarmFred Culpepper Company

Wildcat


Ft. from N. Line

660 Ft. from S. Line

Ft. from E. Line

330 Ft. from W. Line

CWL SW SE

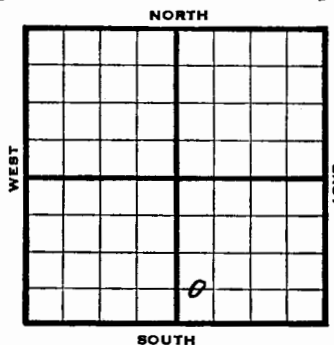

1944

R E P O R T

11/8 Location
11/16 "

11/24 8" @ 63' drlh 1075

11/29 Drlg. 2370

12/6 Hutton 2330
TD 2900'

ABANDONED

Pool Name WildcatMap No. 149 Sec. 3 Twp. 2 R. 14 EWell No. 1 LamparterFred Culpepper

Company

ABANDONED

Contractor

C W L SW SE

SECTION PLAT

Ft. from N. Line

660

Ft. from S. Line

Ft. from E. Line

330

Ft. from W. Line

Nemaha

Location

Rig up

Drilling and Remarks:

Ham Tom 2830

RECORD

Cased _____ in., _____ ft.

Sand _____

Gas _____

Oil _____

Total Depth 2900

PRODUCTION

1st 24 hrs. Nat. _____

1st 24 hrs. after shot _____

Gas _____ Cu. Ft.

Dry Hole _____

Abandoned _____

Date

DEC 6 1944 19S. J. LEWIS

Scout

Pool Name WildcatMap No. 149 Sec. 3 Twp. 2 R. 14 EWell No. 1 LamparterFred Culpepper

Company

FIRST REPORT

Contractor

C W L SW SE

SECTION PLAT

Ft. from N. Line

660

Ft. from S. Line

Ft. from E. Line

330

Ft. from W. Line

NemahaLocation X

Rig up

Drilling and Remarks:

RECORD

Cased _____ in., _____ ft.

Sand _____

Gas _____

Oil _____

Total Depth _____

PRODUCTION

1st 24 hrs. Nat. _____

1st 24 hrs. after shot _____

Gas _____ Cu. Ft.

Dry Hole _____

Abandoned _____

Date

NOV 8 1944 19S. J. LEWIS

Scout

no wall map

Office Small Maps	DK
Cards	Betty
Room Map	MH
Geographical Map	LC
Geological Map	✓
Geological Book	
Geological Box	

no wall map

Office Small Maps	DK
Cards	Betty
Room Map	MH
Geographical Map	✓
Geological Map	✓
Geological Book	
Geological Box	

DK no map
 DK no map