

Section 13 Township 2 Range 14-E

Sec. 13 Twp. 2 R. 14E

Well No. #1 Oream Strahm

Well No. #1 Oream Strahm Farm

Company Carter Oil

Carter Oil Company

Transit Drlg. - Contr. Contractor

Wildcat



990' Ft. from N. Line

330' Ft. from S. Line

330' Ft. from E. Line

330' Ft. from W. Line

NW SW NW

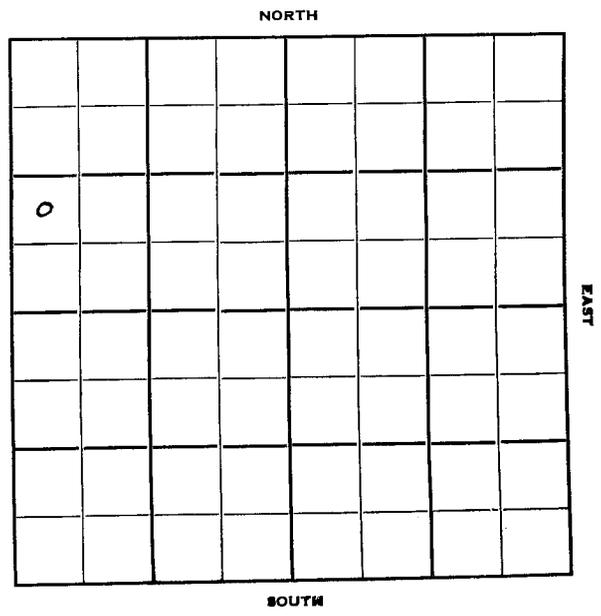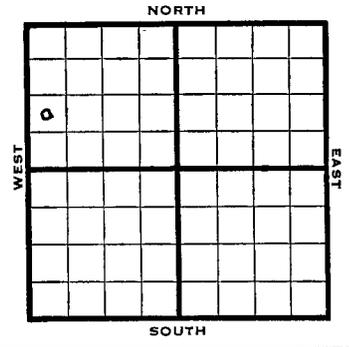

1950	Elev. 1252'	REPORT
8/9	Location	
12/6	Spud 8-4-50	
	Spud 8-4-50	
	Oil Well TD 3929 $\frac{1}{2}$	
	8-5/8" @ 180' Howard 810'	
	Top 845' Lans. 1264'	
	BKC 1593' Miss 2415'	
	Kinderhook 2558' Hunton 2825'	
	DST 2826-29 opn 1 $\frac{1}{2}$ hr Rec. 400' oil	
	BHP 168#	
	Cored 2829-34 Rec. 5' 3' dol. 2' lime	
	DST 2829-34 opn 2 hr Rec. 100' oil	
	10' OCM BHP 31# SIP 1000	
	Cored 2834-39 Rec. 4' 10" 2 $\frac{1}{2}$ ' dol.	
	2' 4" sandy lime	
	Cored 2839-44 Rec. 1' 8" lime 1' 4" dol.	
	10" lime Cored 2844-49 Rec. 4 $\frac{1}{2}$ ' dol.	
	SSO DST 2843-49 opn 2 hr Rec. 30' ocm	
	Cored 2849-54 Rec. 3' 7" dol.	
	Cored 2854-59 Rec 5' 8" dol.	
	DST 2849-59 opn 1 $\frac{1}{4}$ hr Rec. 2100'	
	black oil	
	Cored 2859-64 Rec. 4' 10" 1' grey dol	
	3' 4" dol. 6" dol. DST 2859-64 opn 2	
	hr Rec. 8' socm Cored 2864-74	
	Rec. 4' 2' dol. w/dead stn, odr 2' dol.	
	DST 2864-74 opn 2 hr Rec. 2160'	
	brackish wtr Maq. 3434' Viola 3480	
	SO 3480-3501 SO 3501-04 TD	
	<b>OVER</b>	

1950

(Information brought forward)

5-18-11

12/6 DST 3484-3504 opn 2 hr  
Rec. 1985' fluid 1685' oil  
300' sw  
Cored 3504-06 Rec. 1'10" dol  
good show of oil  
Cored 3506-09 Rec. 3' dol. good sat.  
DST 3504-09 opn 2 hr Rec. 970' oil  
cut wtr salty mud 300' sw  
Cored 3509-14 Rec. 5' 2'1" dol.  
sat. w/oil 11" dol. 2' dol. SP 3737  
DST 3758-68 opn 2 hr Rec. 90' mud  
SO Cored 3768-71 Rec. 2'9"  
sandstone DST 3743-71 opn 2 hr  
Rec. 30' mud Arb. 3809' Regan 3903'  
TD 3929½ 5½" @ 3745  
DC 3767' 3/2857-58 B/1 bfph  
3 gwph 3/2855-56 S½ bo ½ gwph  
S/½ boph 52/2842-55 S/oil & mud  
3/2826-27 B/½ boph 250A  
S/1½ boph 1000A S/100 bo 28/2827-34  
1000 A S/84 bo 3 hr S/54 bo 2 hr.  
P/44 bo 4 hr P/65 bo 6 hr  
Comp. 388 bapd 18% wtr.

COMPLETION



Drilg. Data

Cored 2859-64 Rec. 4' 10" 1' grey dol.  
3' 4" dol. 6" dol. DST 2859-64 open 2 hr  
Rec. 8' socm Core 2864-74 Rec. 4'  
2' dol. w/ dead stain, odor 2" dol.  
DST 2864-74 open 2 hr. Rec. 2160' bracki  
water Naq. 3434 Viola 3480 SO 3480-  
3501 SO 3501-04 TD DST 3484-3504  
open 2 hr. Rec. 1985' fluid 1685' oil  
300' sw Cored 3504-06 Rec. 1' 10" dol.  
good know of oil Cored 3506-09 Rec.  
3' dol. good sat. DST 3504-09 open 2 hr  
Rec. 970' oil cut water salty mud 300' sv  
Cored 3509-14 Rec. 5' 2' 1" dol. sat.  
w/ oil 11" dol. 2' dol. SP 3737  
DST 3758-68 open 2 hr. Rec. 90' mud  
SO Cored 3768-71 Rec. 2' 9" sandstone  
DST 3743-71 open 2 hr. Rec. 30' mud  
Arb. 3809 Regan 3903 TD 3929 $\frac{1}{2}$   
5 $\frac{1}{2}$ " @ 3745 DC 3767 3/ 2857-58  
B/ 1 bfph 3 gwph 3/ 2855-56 S  $\frac{1}{2}$  bo  
 $\frac{1}{2}$  gwph S/  $\frac{1}{2}$  boph 52/ 2842-55 S/ oil &  
mud 3/ 2826-27 B/  $\frac{1}{2}$  boph 250 A  
S/ 1 $\frac{1}{2}$  boph 1000 A S/ 100 bo 28/ 2827-  
34 1000 A S/ 84 bo 3 hr. S/ 54 bo  
2 hr. P/ 44 bo 4 hr. P/ 65 bo 6 hr.  
Comp. 388 bopd 18% water

No Facet

O.W.W.O.

5-513-A

5-513-A

CO. ~~Nebraska~~ ELEV. 1242  
 SEC. 13 TWP. 2 RGE. 14E  
 COMPANY Carter Oil NO. 1  
 OCT 9 57

CO. ~~Nebraska~~ ELEV. 1242  
 SEC. 13 TWP. 2 RGE. 14E  
 COMPANY Carter Oil NO. 1  
 NOV 27 57  
 COMPLETE

FARM Oregon Strahm  
 LOC. NW SW NW (OWN) O.W.W.O.

FARM Oregon Strahm  
 LOC. NW SW NW (OWN) O.W.W.O.

Ht.	2825	GEOL.	
Mag.	3834	CONTR.	
Vi.	3480	POOL	Sabetha
St. P	3737	SPUD	5" @ 3745/300
Arb.	3809		PB 2707 MICT to
Rea.	3903		perf Viola
PCh.	3929		
TD	3929		

Ht.	2825	GEOL.	
Mag.	3834	CONTR.	
Vi.	3480	POOL	Sabetha
St. P	3737	SPUD	5" @ 3745/300
Arb.	3809		PB 2707 MICT to
Rea.	3903		perf Viola OCT 10 57
PCh.	3929		OCT 23 57 S @ Hunter
TD	3929		product CO
			OCT 30 57 New TD 3510

2737  
 2925  
 9' V

2737  
 2925  
 9' V

PP 13487-90 AS 200A @ 3 BOPH  
 + 1/2 BOPH 9 hrs PR 13483-87  
 NOV 6 57 NOV 13 57 P 20 B0 + 160 B W  
 24 hrs NOV 27 57

20 B0 + 160 B W

Viola 3487-87  
 3487-90