

Section **20** Township **2** Range **14-E**

Well No. **#1 Lancaster**

Company **Hugoton Prod**

Sec. **20** Twp. **2** R. **14-E**

Well No. **#1 Lancaster** Farm

**Hugoton Prod** Company

Contractor

**Wildcat**



\_\_\_\_\_ Ft. from N. Line

**330** Ft. from S. Line

**330** Ft. from E. Line

\_\_\_\_\_ Ft. from W. Line

**SE SE SE**

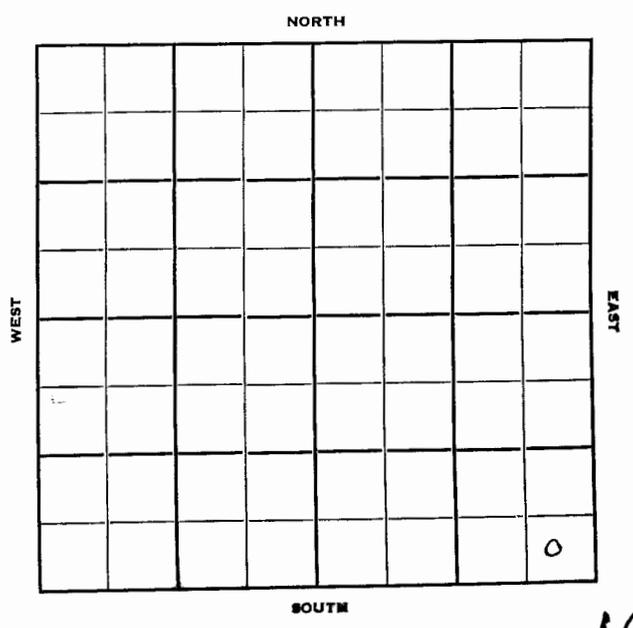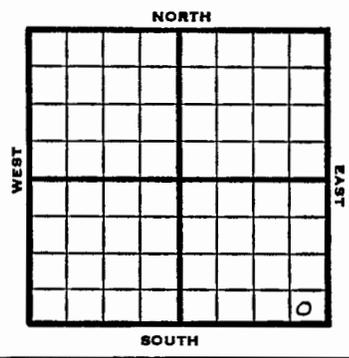

16


1950		Elev 1324	REPORT
8/2	Spud 7-29-50	8" @ 183	
	WOC		
8/23	8" @ 183	Top 932	Lans 1314
	Miss 2519	Maq 3588	Kinderhook 2700 Hunton ?
	TD 3738	D&A	Viola 3651
<b>ABANDONED</b>			

**Kansas**

Wildcat

County Nemaha State Kansas  
 Sec. 20 (Blk. Twp.) 2 (Sur. Rge.) 14E Map No.  
 Operator Hugoton Prod.  
 Well No. 1 Farm Lancaster  
 Elev. 1324 Location SE SE SE

Map No. \_\_\_\_\_ Sec. 20 Twp. 2 R. 14E  
 Well No. 1 Lancaster  
Hougoton Prod. Company  
 \_\_\_\_\_ Contractor

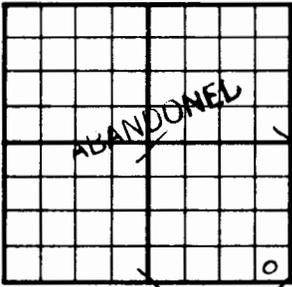

330 Ft. From S Line SE  
330 Ft. From E Line Quarter  
 1st. Report \_\_\_\_\_  
 Completion AUG 23 1950  
 Remarks \_\_\_\_\_  
Wildcat  
 Spudding Date 7-29-50

SE SE SE  
 \_\_\_\_\_ Ft. from N. Line  
330 Ft. from S. Line  
330 Ft. from E. Line  
 \_\_\_\_\_ Ft. from W. Line

**SECTION PLAT**



Drlg. Data D & A TD 3738  
8" @ 183 Top. 932 Lans. 1314 Miss. 2519  
Kinderhook 2700 Hunton 2913 Maq. 3588  
Viola 3651 TD 3738 D & A

Nemaha County

Location \_\_\_\_\_  
 Rig up \_\_\_\_\_  
 Drilling and Remarks:  
  
Spud 7-29-50  
8" @ 183  
  
WOC

**RECORD**

Cased \_\_\_\_\_ in., \_\_\_\_\_ ft.  
 Sand \_\_\_\_\_  
 Gas \_\_\_\_\_  
 Oil \_\_\_\_\_  
 Total Depth \_\_\_\_\_  
**PRODUCTION**  
 1st 24 hrs. Nat. \_\_\_\_\_  
 1st 24 hrs. after shot \_\_\_\_\_  
 Gas \_\_\_\_\_ Cu. Ft.  
 Dry Hole \_\_\_\_\_  
 Abandoned \_\_\_\_\_

Date AUG 2 1950 19 J. E. TYRA Scout

J. E. TYRA