

Section 14 Township 2 Range 14E

Sec. 14 Twp. 2 R. 14 E

Well No. #2 Steibler

Well No. # 2 Steibler Farm

Company J. E. Palensky & Sons

J. E. Palensky & Sons Company

Stout Drig. Contractor



990 Ft. from N. Line

\_\_\_\_\_ Ft. from S. Line

990 Ft. from E. Line

\_\_\_\_\_ Ft. from W. Line

SW NE NE

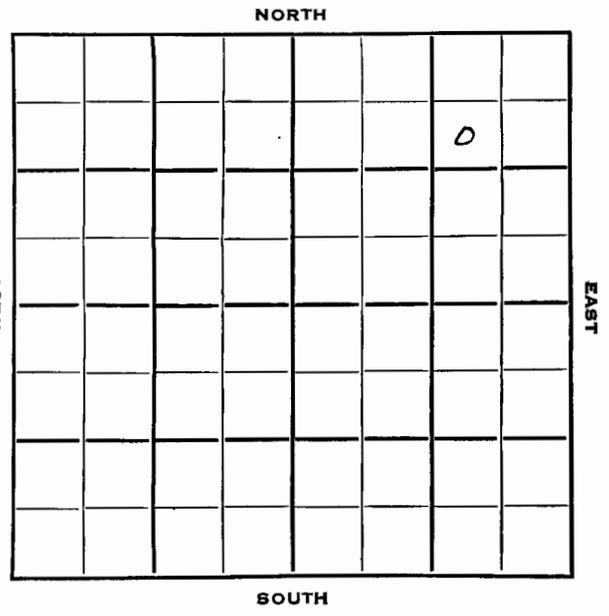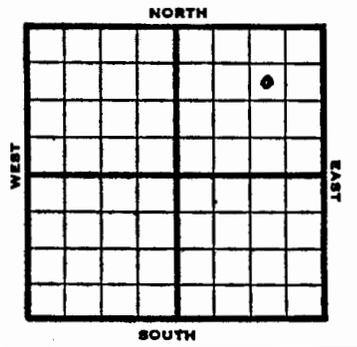

1953 Elev. 1278' KB **REPORT**

2/18 Location  
 3/11 Spud 2-23-53  
 D & A TD 2928' 8" @ 64  
 Lans. 1299 Miss 2508' Kh. 2652  
 Misener 2902' Hunton 2907'  
 SCHLUMBERGER TOPS:  
 Miss 2512' Kh. 2652' Misener 2906'  
 Hunton 2913'  
 TD 2928' D & A

**ABANDONED**

