

Section 23 Township 2 Range 14 E

Well No. # 1 Henry


Company O. O. Wallace et al

Sec. 23 Twp. 2 R. 14 E

Well No. #1 Henry Farm

O.O. Wallace et al Company

Stout Drlg. Contractor

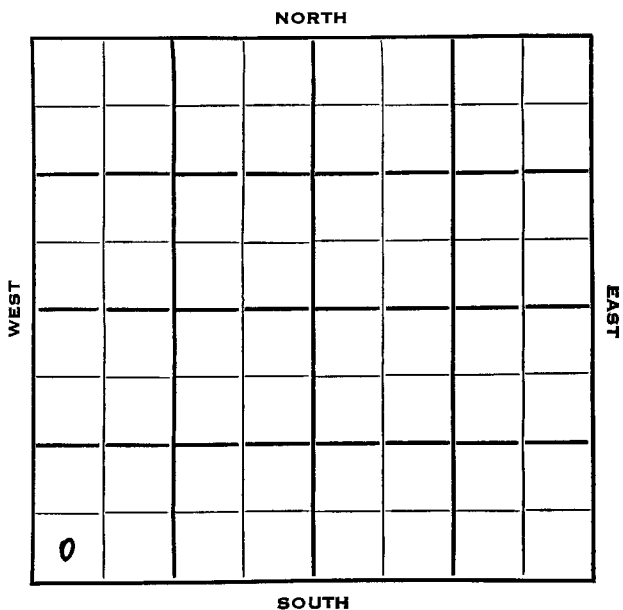

E. Strahm Pool


 Ft. from N. Line

300 Ft. from S. Line

 Ft. from E. Line

300 Ft. from W. Line

SW SW SW

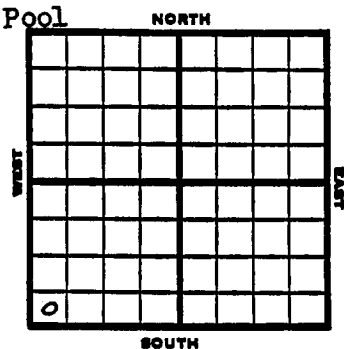

1953 Elev. 1263' RB REPORT

6/10 Loc.

7/1 Spud 6-11-53 D & A TD 2874
8" @ 146 Lans. 1272 B KC 1599
Burgess 2408 Miss 2422 Hunton 2861
TD 2874'
D & A

ABANDONED

13

County	Nemaha		State	Kansas	
Sec.	23	(Blk. Twp.)	2	(Sur. Rge.)	14E Map No.
Operator	O. O. Wallace et al.				
Well No.	1	Farm	Henry		
Elev.	1263 RB	Location	SW SW SW		
		330 Ft. From	S Line	SW	
		330 Ft. From	W Line	Quarter	
		1st. Report			
		Completion	JUL 1 1953		
		Remarks	E. Strahm Pool		
		Stout Drlg. - Contr.			
		Spudding Date	6-11-53		
Drlg. Data	D & A		TD 2874		
8" @ 146 Lans. 1272 B KC 1599					
Burgess 2408 Miss. 2422 Hunton 2861					
TD 2874					

D & A

J. G. McGEHEE

County	Nemaha		State	Kansas	
Sec.	23-	(Blk. Twp.)	2	(Sur. Rge.)	14E Map No.
Operator	O. O. Wallace et al.				
Well No.	1	Farm	Henry		
Elev.		Location	SW SW SW		
		330 Ft. From	S Line	SW	
		330 Ft. From	W Line	Quarter	
		1st. Report	JUN 10 1953		
		Completion			
		Remarks	Stout Drlg. - Contr.		
		Spudding Date			
Drlg. Data	E. Strahm Pool				
Location					

J. G. McGEHEE