

Section 26 Township 2 Range 14E

Sec. 26 Twp. 2 R. 14 E

Well No. #1 Edelman

Well No. # 1 Edelman Farm

Company O. O. Wallace & Howitt

O. O. Wallace & Howitt Company

Stout Drlg. Contractor

Wildcat

330 Ft. from N. Line



\_\_\_\_\_ Ft. from S. Line

\_\_\_\_\_ Ft. from E. Line

330 Ft. from W. Line

NW NW NW

Carter support

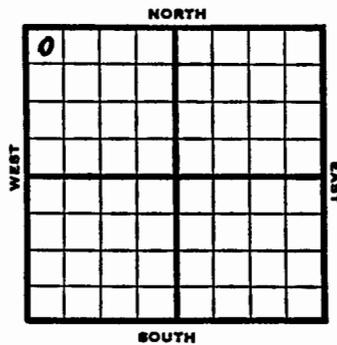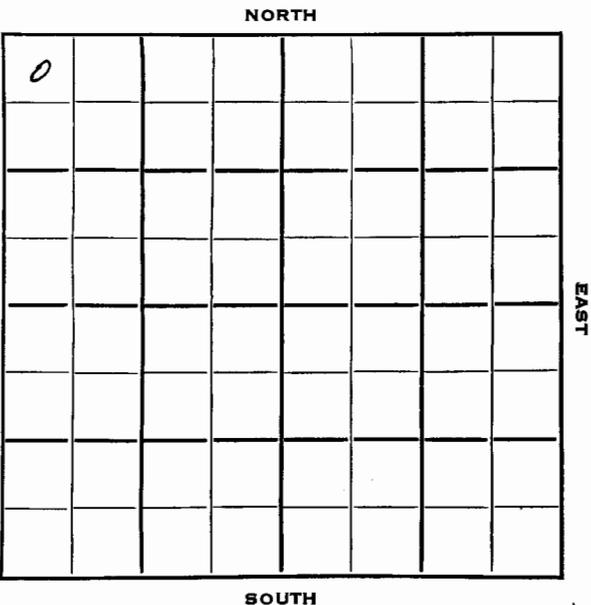

4

|                  |   |
|------------------|---|
| 1953             | Elev. 1258 RB REPORT  |
| 3/11             | Location  |
| 6/17             | Spud 3-20-53<br>Oil Well<br>TD 2837'<br>8" @ 134'<br>KC 1264, B KC 1592, Burgess 2399,<br>Miss Ch, 2412, Miss dol. 2448, Miss<br>lime 2433, Kh. 2576, Hunton 2826.<br>DST 2827-37 opn 1/2 hr, rec 30 & hocrn,<br>30' clean oil 640#<br>TD 2837'<br>5" @ 2829'<br>CO to 2837<br>FU 50' oil 12 hr. DD 2851<br>B/ 1 1/2 boph 1000 A S/ 6 boph 6 hr.<br>FU 1900' oil 8 hr. P/ 45 bopd<br>Comp. 25 bopd. |
| <b>COMPLETED</b> |   |

