

1513130042000

FORM 51 25M 3-49 PETROL

Nemaha KANSAS

FORM 254-B
IOM 9-49 PETROL

NEMAH

KANSAS

Sec. 27 Twp. 2 R. 14E ✓

Section 27 Township 2 Range 14E

Well No. #1 Parli School Dist. #20

Well No. #1 Parli School Dist. #20 Farm

Company Carter Oil

Carter Oil Company

Transit Drlg. Contractor

Strahm Pool



330' Ft. from N. Line

Ft. from S. Line

Ft. from E. Line

990' Ft. from W. Line

NE NW SW

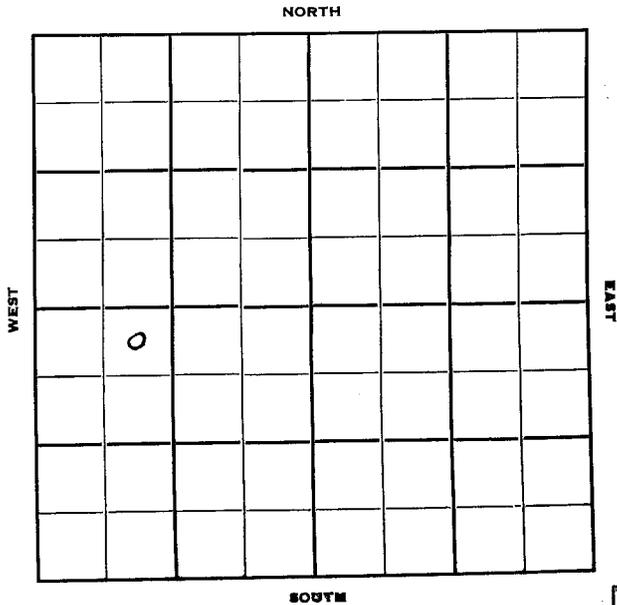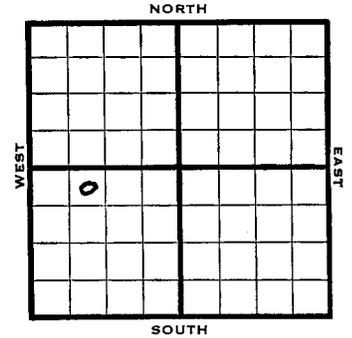

12

1950	Elev. 1308'	REPORT
8/23	Location	
11/8	Spud 9-10-50	
	Oil Well TD 3559'	
	8-5/8" @ 172' How rd 864'	
	Top 906' Lans. 1307' BKC 1630'	
	SSO 2425-28 Miss Chert 2428	
	Kinderhook 2588' Hunton 2770'	
	DST 2771-81 opn 2 hr	
	Rec. 15' OCM 10' oil	
	DST 2781-2845 opn 2 hr	
	Rec. 30' mud SSO	
	DST 2845-65 opn 2 hr	
	Rec. 5' SOCM	
	DST 2872-82 opn 1 1/2 hr	
	Rec. 390' hvy oil	
	DST 2882-87 opn 4 hr	
	Rec. 450' hvy oil	
	DST 2887-92 opn 2 hr Rec. 2' hvy	
	oil 8' mud DST 2892-97 opn 2 hr	
	Rec. 60' hvy oil 10' mud	
	DST 2899-2904 opn 2 hr	
	Rec. 527' hvy oil	
	DST 2904-09 opn 2 hr Rec. 61' wtr	
	Mag 3497' Viola 3546-59 TL	
	DST 3550-59 opn 2 hr	
	Rec. 3294' clean oil 124' OCM	
	5 1/2" @ 3550 FU 3400' oil in 1 hr	
	S/146 BO 6 hr. Comp. 3000 BOED	
	COMPLETED	

