

Section 28 Township 2 Range 14E

Well No. 1 Koch-Ramson

Company Carter

Well No. #1 Koch-Ramson Farm

Carter Company

Strahn Pool


990' Ft. from N. Line

_____ Ft. from S. Line

990' Ft. from E. Line


_____ Ft. from W. Line

SW NE SE

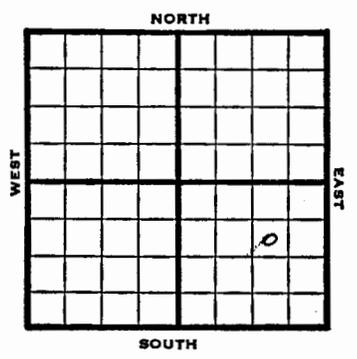

Strahn

NORTH

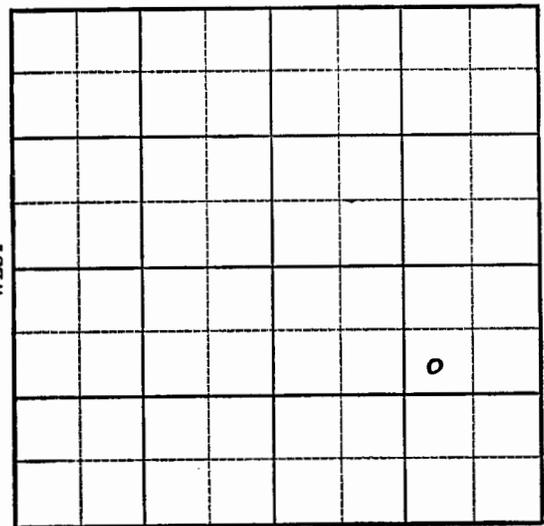

SOUTH

9

1949	Elev. 1244' REPORT
1/12	Location
1/19	"
1/26	"
2/2	10" @ 165' Drlg. 460'
2/9	Topeka 840' K.C. 1260' Mississippi 2439' Drlg 2600'
2/16	Kind 2641' Hunton 2876' TD 2970'
	ABANDONED

Map No. _____ Sec. 28 Twp. 2 R. 14E

Well No. 1 Koch - Ramson

Carter _____ Company

FIRST REPORT

Contractor

SW NE SE

SECTION PLAT

990 Ft. from N. Line
____ Ft. from S. Line
990 Ft. from E. Line
____ Ft. from W. Line

Nemaha County

Location x

Rig up _____

Drilling and Remarks:

RECORD

Cased _____ in., _____ ft.

Sand _____

Gas _____

Oil _____

Total Depth _____

PRODUCTION

1st 24 hrs. Nat. _____

1st 24 hrs. after shot _____

Gas _____ Cu. Ft.

Dry Hole _____

Abandoned _____

Date

JAN 12 1949 19

S. J. LEWIS Scout

Map No. K149 Sec. 28 Twp. 2 R. 14E

Well No. 1 Koch - Ramson

Carter _____ Company

ABANDONED

Contractor

SW NE SE

SECTION PLAT

990 Ft. from N. Line
____ Ft. from S. Line
990 Ft. from E. Line
____ Ft. from W. Line

Nemaha County

Location _____

Rig up _____

Drilling and Remarks:

Nov 26 41

Jan 28 46

RECORD

Cased _____ in., _____ ft.

Sand _____

Gas _____

Oil _____

Total Depth 2970

PRODUCTION

1st 24 hrs. Nat. _____

1st 24 hrs. after shot _____

Gas _____ Cu. Ft.

Dry Hole _____

Abandoned _____

Date

FEB 16 1949 19

S. J. LEWIS Scout