

Section 28 Township 2-S Range 14-E

Sec. 28 Twp. 2-S R. 14-E ✓

Well No. #2 Koch-Ransom

Well No. #2 Koch-Ransom Farm

Company Carter Oil

Carter Oil Company

Contractor

Stralm



330 Ft. from N. Line

_____ Ft. from S. Line

330 Ft. from E. Line

_____ Ft. from W. Line

NE NE SE

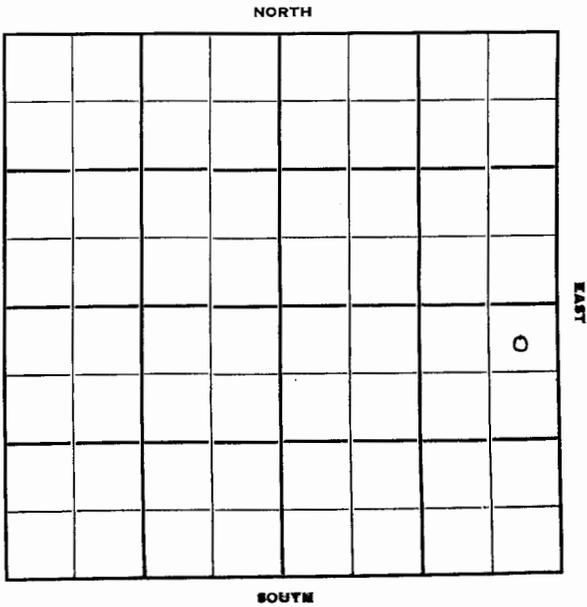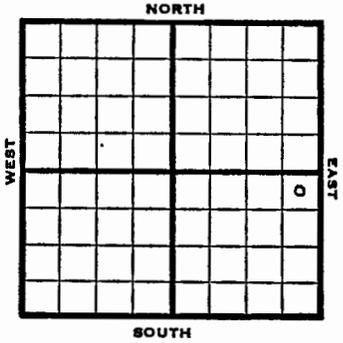

9

1950	Elev 1287	REPORT
6/7	Spud 6-5-50 Drlg. 100	
8/2	Spud 6-5-50 8 5/8" @ 181 Howard 845 Heeb 1135 Miss 2475 Hunton 2857 Cored 2858-60 rec 1 1/4" line w/free oil and good odor. Corec 2860-61 rec lime w/sli show of oil Corec 2861-72 rec dol. DST 2857-62 opn 2 hr rec 5' drlg mud & 5' free oil DST 2875-80 opn 2 hr, rec 5' socm DST 2880-93 opn 2 hr rec 5' mud 1' clean oil Maq 3517 DST 3579-90 opn 1 hr rec 10' mud 15' SW DST 3585-95, opn 2 hr rec 1870' mud & salty wtr. Simp sd 3823 DST 3847-51, opn 1 hr rec 2' mud Arb 3890 Granite 3947 DST 3936-68 opn 2 hr rec 1510' salty wtr. PB 3788 5 1/2" @ 2670 3000 acid, Input 200 bw 1 3/4 hr Comp for SWD COMPLETED	<p style="text-align: right;">Topeka 884 Lans 1292 Kinderhook 2611</p> <p style="text-align: right;">Viola 3578 Regan 3938</p>

3823
2857
2857
2857

County Nemaha State Kansas
 Sec. 28 (Blk. 2 (Twp. 2 (Sur. 14E (Rge. 14E Map No. _____
 Operator Carter Oil
 Well No. 2 Farm Koch-Ransom
 Elev. 1287 Location NE NE SE

COMPLETE

330 Ft. From N Line SE
330 Ft. From E Line Quarter
 1st. Report _____
 Completion AUG 2 1950
 Remarks _____
 Spudding Date 6-5-50

Drlg. Data Strahm Pool
8 5/8" @ 181 Howard 845 Topeka 884
Heeb. 1135 Lans. 1292 Miss. 2475
Kinderhook 2611 Hunton 2857
Cored 2858-60 Rec. 14" line w/ free oil
and good odor Cored 2860-61 Rec. line
w/ sli. show of oil Cored 2861-72
Rec. dol. DST 2857-62 open 2 hr. Rec.
5' drlg. mud DST 2862-75 open 2 hr.
Rec. 25' drlg. mud & 5' free oil
DST 2875-80 open 2 hr. Rec. 5' soon
DST 2880-93 open 2 hr. Rec. 5' mud
DST 2892-2900 open 2 hr. Rec. 10' mud
1' clean oil Maq. 3517 Viola 3578
DST 3579-90 open 1 hr. Rec. 10' mud

J. E. TYRA

Map No. _____ Sec. 28 Twp. 2S R. 14E
 Well No. 2 Koch-Ransom
Carter Oil Company
 Contractor _____

330 Ft. from N. Line
 _____ Ft. from S. Line
330 Ft. from E. Line
 _____ Ft. from W. Line

SECTION PLAT

FIRST REPORT			

Nemaha

Location _____ Rig up _____ Drilling and Remarks: <u>Spud 6-5-50</u> <u>Drlg. 100</u>	RECORD Cased _____ in., _____ ft. Sand _____ Gas _____ Oil _____ Total Depth _____ PRODUCTION 1st 24 hrs. Nat. _____ 1st 24 hrs. after shot _____ Gas _____ Cu. Ft. Dry Hole _____ Abandoned _____
---	---

Date JUN 7 1950 19 J. E. TYRA Scout

Orig. Data

MISC.
 Pierce Map
 DST 3585-95
 open 2 hr.
 Regan 3938
 DST 3936-68
 open 2 hr.

15' salt water
 Rec. 1870' mud & salty water
 3823 DST 3847-51 open 2 hr.
 2' mud Arb 3890 Regan 3938
 Granite 3947 DST 3936-68 open 2 hr.
 Rec. 1510' salty water PB 3788 5 1/2" @
 3670 3000 acid Input 200 bw 1 3/4 hr.

Comp for SWD