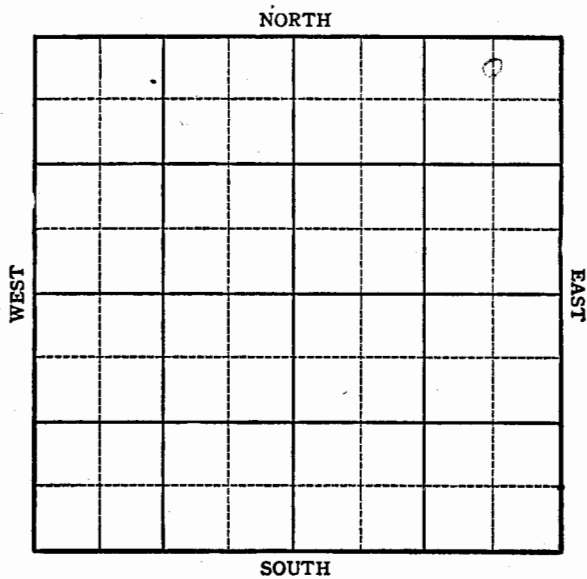


KANSAS

Brown County

FORM 51 5M BRIX

Section 15 Township 2S Range 16E
Well No. #1 Yaussi
Company Hiawatha Community

FORM 252-A
5M 9-44 PETROL


KANSAS Brown County

Sec. 15 Twp. 2S R. 16E
Well No. #1 Yaussi Farm
Hiawatha Community Company

Wildcat

330 Ft. from N. Line Ft. from S. Line660 Ft. from E. Line Ft. from W. Line

C N L N E N E

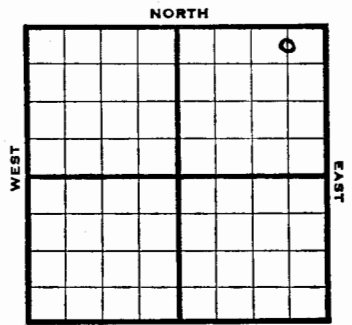

1944 Elev. 970 REPORT

10-25 Set 8" @ 43'

Hunton 2655

Abandoned No. 12, 1941 at a

Total Depth of 2766'

FIRST REPORT

and
ABANDONED

Pool Name WildcatMap No. N/V Sec. 15 Twp. 2 R. 16EWell No. 1 YaussiHiawatha Community CompanyCORRECTION Contractor

C N L NE NE

Fl. 970
SECTION PLAT330 Ft. from N. Line

Ft. from S. Line

660 Ft. from E. Line

Ft. from W. Line

Brown

Location

Rig up

Drilling and Remarks:

8"-43'

Hunton 2655

Abandoned

Nov. 12, 1941

RECORD

Cased _____ in. _____ ft.

Sand _____

Gas _____

Oil _____

Total Depth 2766

PRODUCTION

1st 24 hrs. Nat. _____

1st 24 hrs. after shot _____

Gas _____ Cu. Ft.

Dry Hole _____

Abandoned _____

Date

OCT 25 1944 19

S. J. LEWIS Scout

Pool Name WildcatMap No. N/V Sec. 15 Twp. 2 R. 16EWell No. 1 YaussiHiawatha Community CompanyCORRECTION Contractor

C N L NE NE

SECTION PLAT

330 Ft. from N. Line

Ft. from S. Line

660 Ft. from E. Line

Ft. from W. Line

Brown

Location

Rig up

Drilling and Remarks:

Abandoned Nov 12
1941

Reported 1-2-15E

RECORD

Cased _____ in. _____ ft.

Sand _____

Gas _____

Oil _____

Total Depth 2766

PRODUCTION

1st 24 hrs. Nat. _____

1st 24 hrs. after shot _____

Gas _____ Cu. Ft.

Dry Hole _____

Abandoned _____

Date

OCT 18 1944 19

S. J. LEWIS Scout

If this an Old well drilling deeper
or abandoned well corrected

Please state if well is in the SW NE SW
of a section, township and range.
and corrected to SW NE NW of some
section, township and range.

Sandy: I have all girls working
in the scouting department and I will
appreciate complete details on all tickets
They do not understand how to handle
unless you give it complete.
We cover about 10 states and I can not
look at all the tickets.

Thanks
Sam

I do not have a record of a well in
1-2-15E

Misc. Small Maps
Cards <i>Betty</i>
Tracing
France Map
Scarborough's Map
Moody Map
Geological Dept.
Moody Map Book